


PREPARED FOR:  
WESTVIEW ESTATES  
4885 SW WESTVIEW DRIVE  
CORNELIUS, OREGON

CLAIM OF BENEFICIAL USE MAP  
SECTION 14, T1S, R3W, W.M.  
WASHINGTON COUNTY, OREGON  
APPLICATION #G-16311,  
PERMIT #G-16489

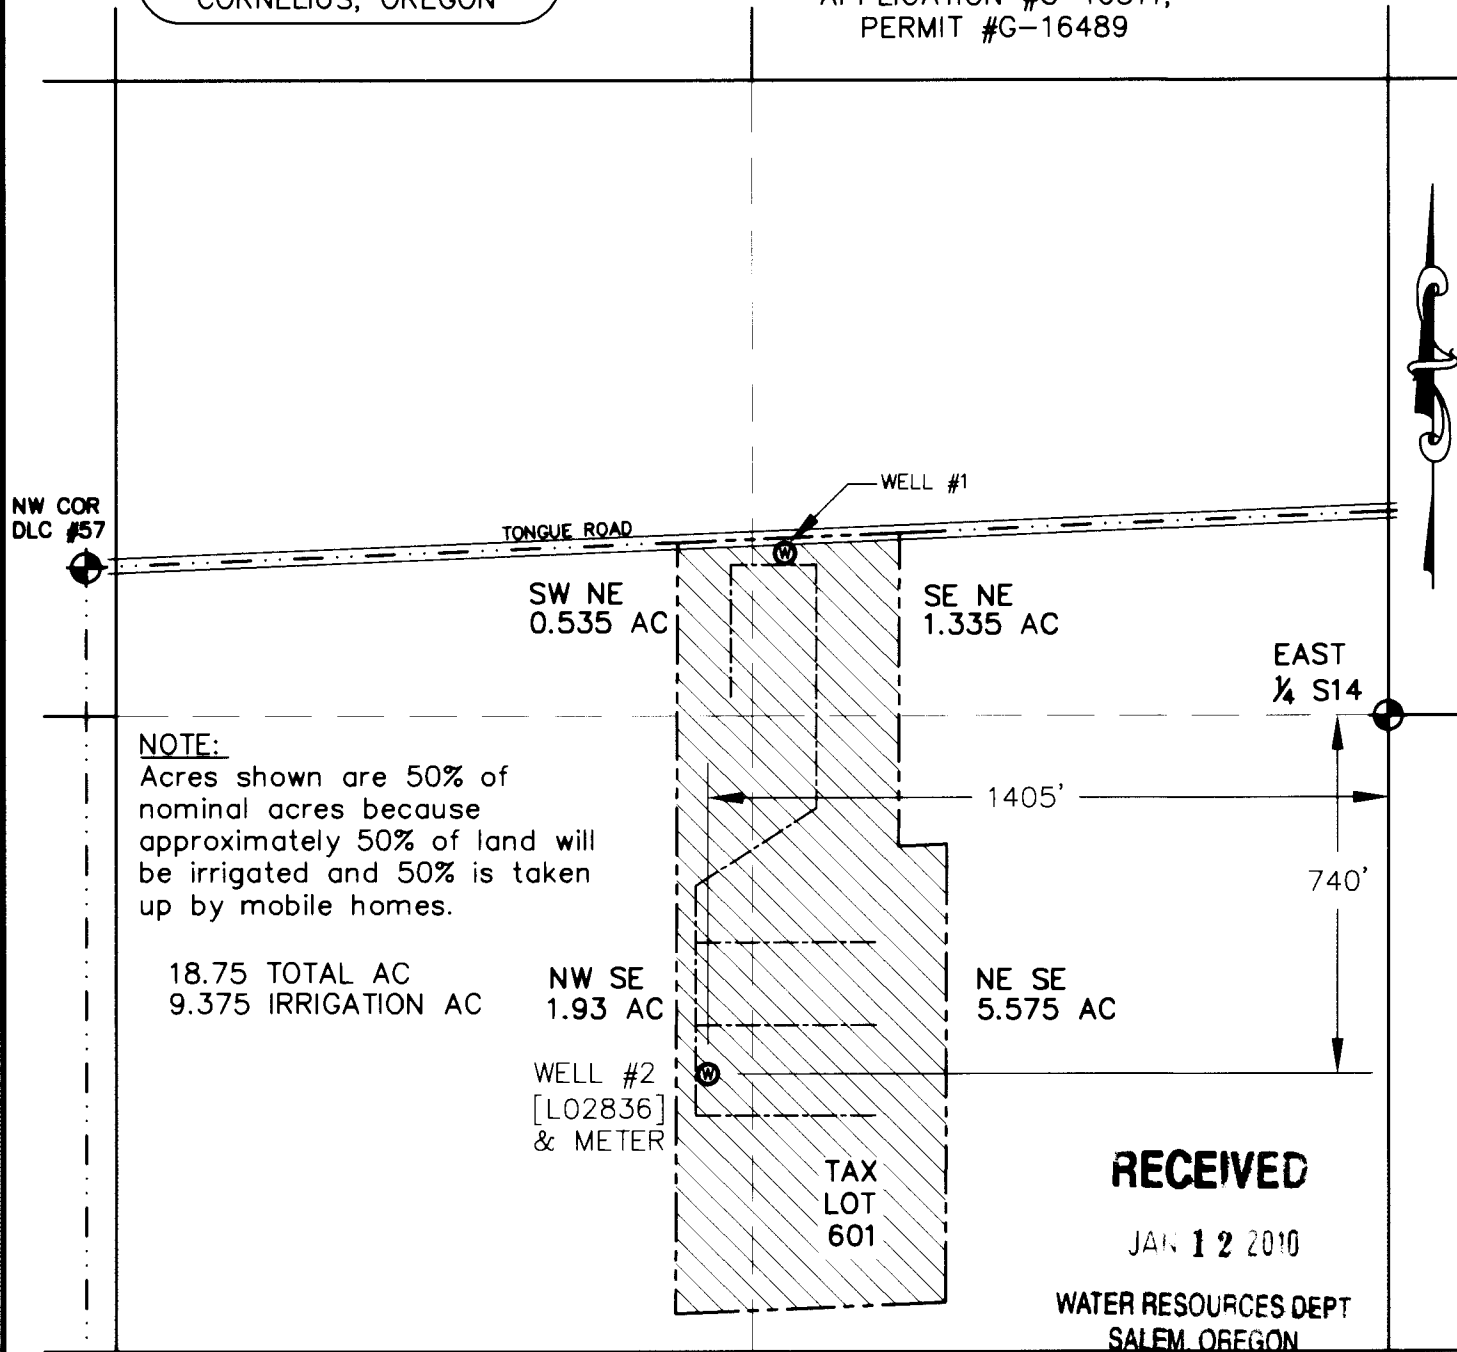

**NOTE:**  
Acres shown are 50% of nominal acres because approximately 50% of land will be irrigated and 50% is taken up by mobile homes.

18.75 TOTAL AC  
9.375 IRRIGATION AC

NW SE  
1.93 AC  
WELL #2  
[L02836]  
& METER

TAX  
LOT  
601

**RECEIVED**

JAN 12 2010

WATER RESOURCES DEPT  
SALEM, OREGON



**LEGEND:**

- ⊙ WELL LOCATION
- - - - - APPROXIMATE PROPERTY LINE
- MAIN WATER PIPELINE

MAP BASE: 2009 PORTLAND METRO AERIAL, 1S314  
TAX MAP & "LAURELWOOD" USGS TOPO MAP.

INSPECTED ON DECEMBER 17,  
2009 BY WILLIAM KNESS

THE PURPOSE OF THIS MAP IS TO IDENTIFY THE  
LOCATION OF A WATER RIGHT ONLY. IT IS NOT  
INTENDED TO PROVIDE DIMENSIONS OR LOCATIONS  
OF PROPERTY OWNERSHIP LINES.

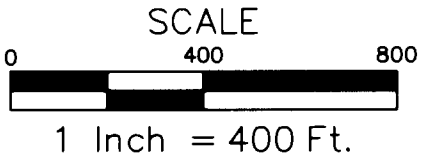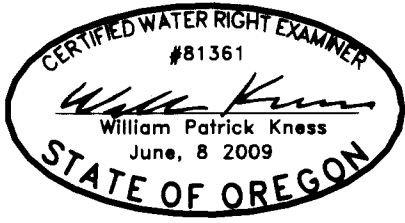

Project: 304-2-043  
File: 3042043G 2009COBU.dwg  
By: EAU/WPK  
Checked by: EAU  
Date: 12-15-2009