
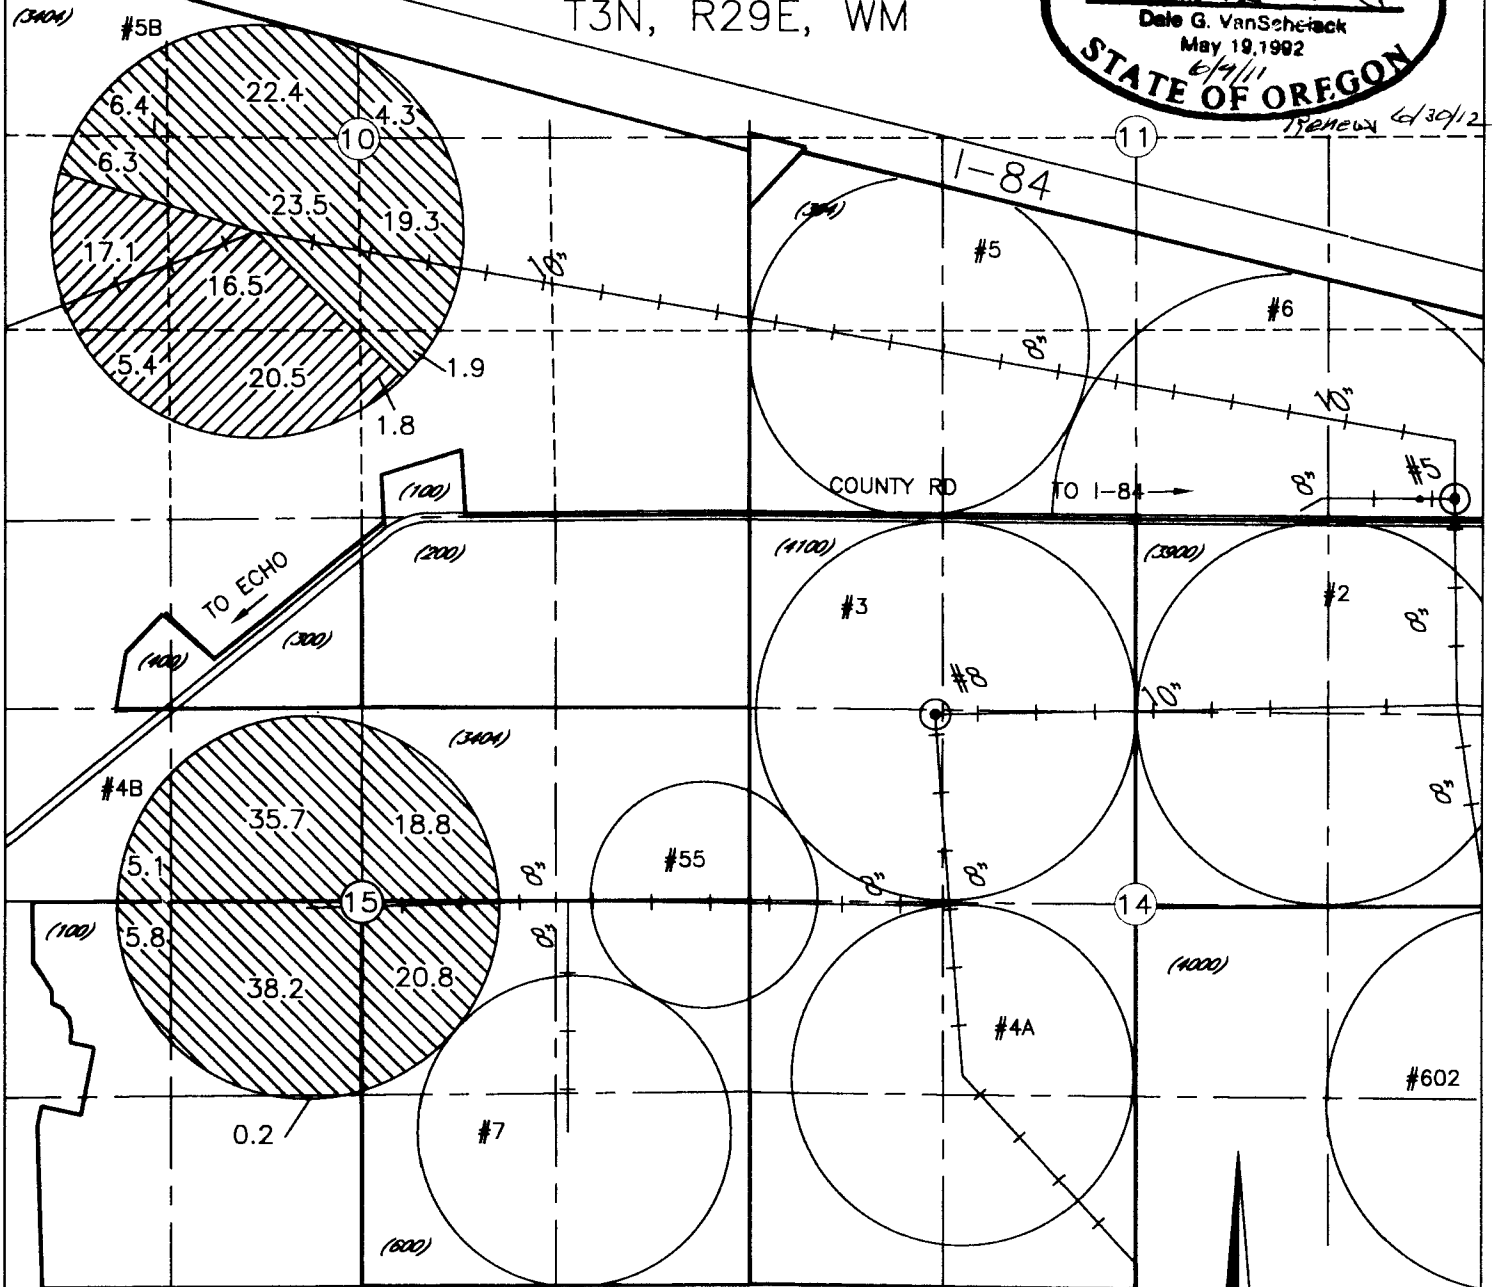


AMENDED FINAL PROOF SURVEY
 UNDER T-6787 ECHO IRRIGATION DISTRICT
 FOR
 RICK & DOUGLAS HALE
 T3N, R29E, WM

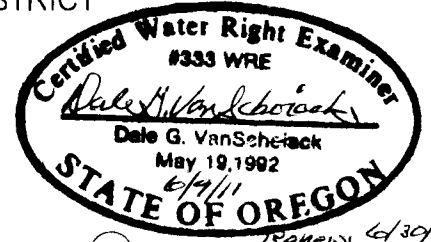



AUTHORIZED POINT OF APPROPRIATION
 HALE WELL NO #5
 LOCATED 60'N + 590'W FROM SE COR, SEC 11

AREA OF USE

- 61.3 Ac PRIMARY PERMIT G-2415
 SUPPLEMENTAL PERMIT G-4969
- 208.7 Ac PRIMARY PERMIT G-4969

LEGEND

- 8" PIPE SIZE
- #7 CIRCLE NUMBER
- #5 HALE'S WELL #5
- (#1000) TAX LOT

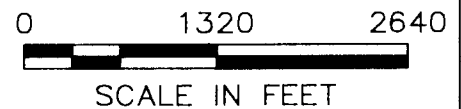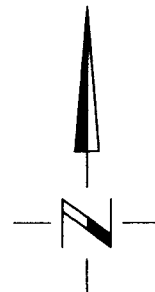

NOTE: THE PURPOSE OF THIS MAP IS TO IDENTIFY THE APPROXIMATE LOCATION OF THE WATER RIGHT. IT IS NOT INTENDED TO PROVIDE INFORMATION RELATIVE TO THE LOCATION OF PROPERTY OWNERSHIP BOUNDARY LINES.

AMENDED MAP 6-6-11