


T.7S., R.2W., W.M.

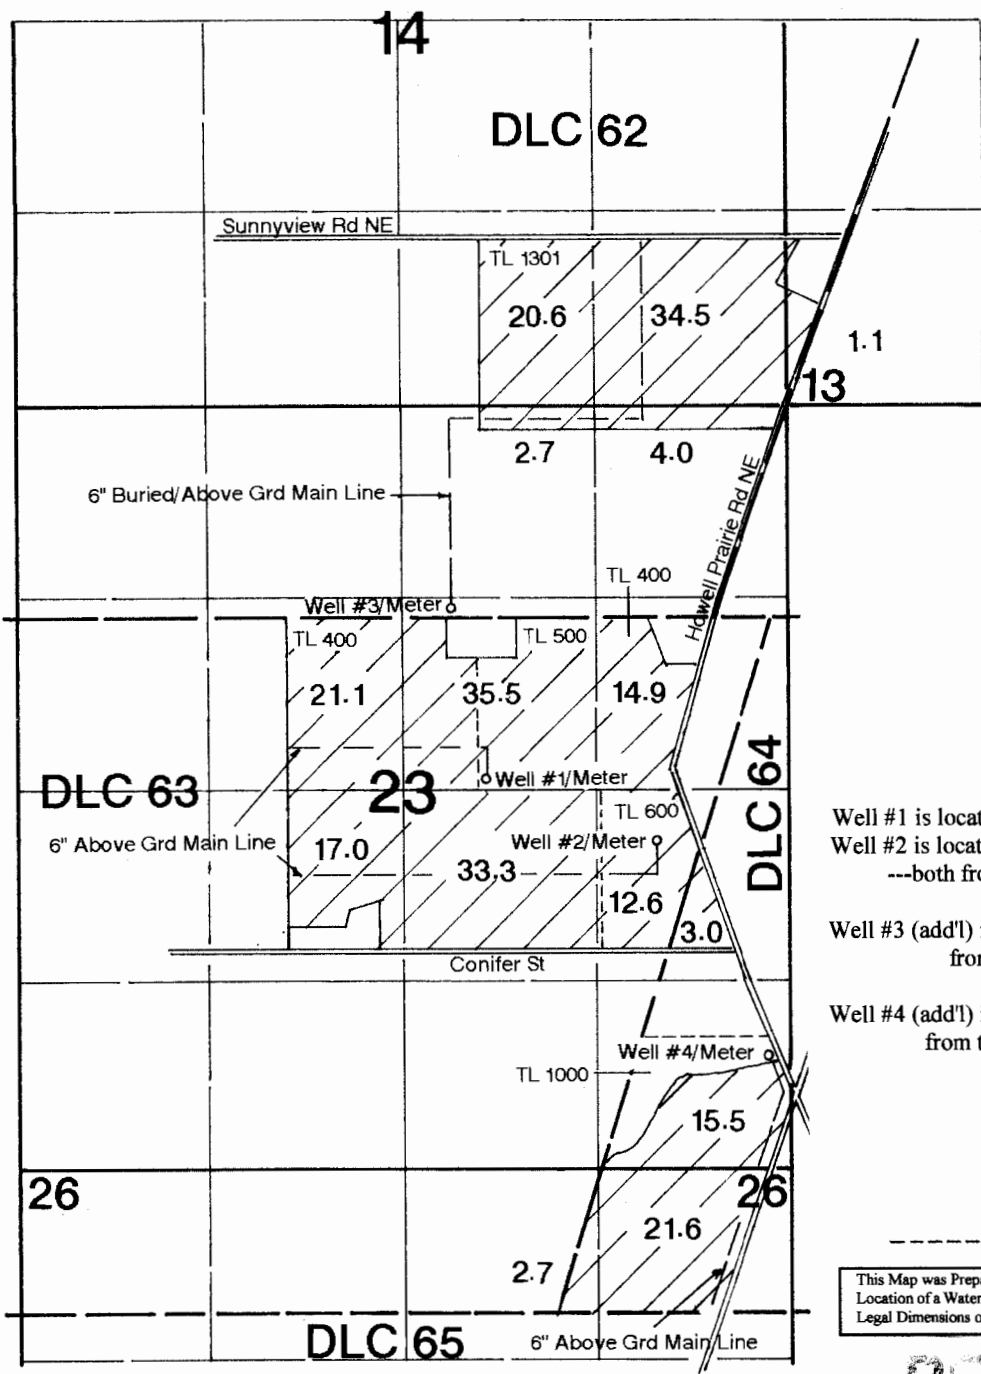

Well #1 is located 70' N & 560' E
 Well #2 is located 320' S & 1730' E
 ---both from the center of Section 23.

Well #3 (add'l) is located 50' N & 1780' W
 from the SE corner of DLC 62.

Well #4 (add'l) is located 780' N & 150' W
 from the SE corner of Section 23.

----- Approx. Tax Lot Line

This Map was Prepared for the Purpose of Identifying the Location of a Water Right Only and is Not Intended to Provide Legal Dimensions or Location of Property Ownership Lines.


Final Proof Survey

In the Name of

Mike Thompson

Application#: G-12000 Permit #: G-11014

Surveyed on March 4, 2014 by JM Schuette

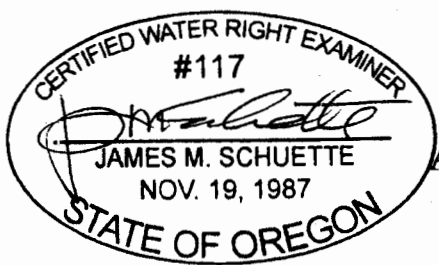

EXPIRES: 6/30/2014

