


**RECEIVED**

MAY 19 2014

WATER RESOURCES DEPT  
SALEM, OREGON

FINAL PROOF MAP T-8972  
NE1/4NE1/4, SE1/4NE1/4  
SEC. 10, T.39S., R.3W., W.M.  
JACKSON COUNTY, OREGON  
FOR  
JACQUELINE LUCAS  
485 LITTLE APPLGATE ROAD  
JACKSONVILLE, OREGON 97530

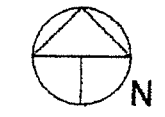

Scale: 1"=400'  
Date: August 7, 2006

**LEGEND**

- Found Survey Monument
- Denotes Building
- === Denotes Driveway
- - - Denotes Mainline Pipe
- BP/FM Denotes Booster Pump & Flow Meter
- ▨ Denotes Area Under Special Order  
Volume 61, Pages 409-411,  
Priority Date 1854

Point of Diversion No. 1 - Situated 480' West  
and 230' North of South One-Quarter Corner,  
Section 3. Fish Screen at Point of Diversion.


This map was prepared for the purpose of  
identifying the location of a water right only  
and is not intended to provide legal dimen-  
sions or location of property ownership.



HAROLD L. CENTER  
2604 David Lane  
Medford, OR. 97504  
Phone 541-535-6108  
Oregon Certificate No. 152  
Certificate Renewal Date: 12/31/2007

Farmers Ditch

# T 39 S, R 3 W, W.M.

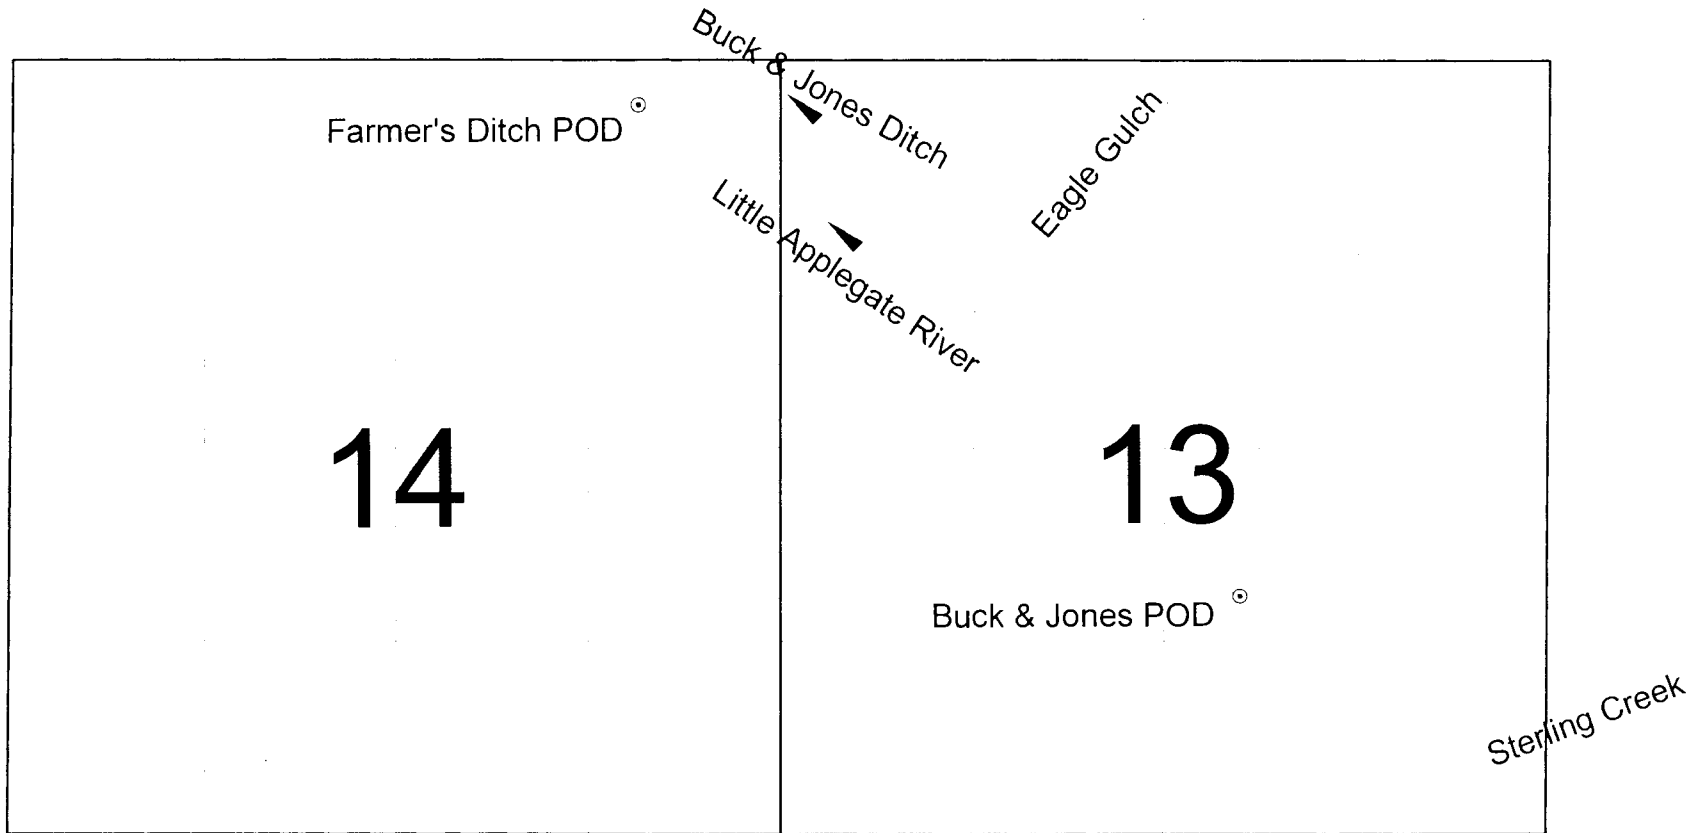

Final Proof Survey  
under  
T-8972

Little Applegate River



Farmer's Ditch POD - GPS coordinates: Latitude 42.18400, Longitude -123.0174  
 Buck & Jones Ditch POD - GPS coordinates: Latitude 42.17508, Longitude -123.0018

0 0.5 1 Miles



Scale 1 inch = 1320 feet