


RECEIVED

MAY 19 2014


WATER RESOURCES DEPT
SALEM, OREGON

FINAL PROOF MAP T-8965
NE1/4NE1/4, SE1/4NE1/4
SEC. 10, T.39S., R.3W., W.M.
JACKSON COUNTY, OREGON
FOR
JACQUELINE LUCAS
485 LITTLE APPLGATE ROAD
JACKSONVILLE, OREGON 97530

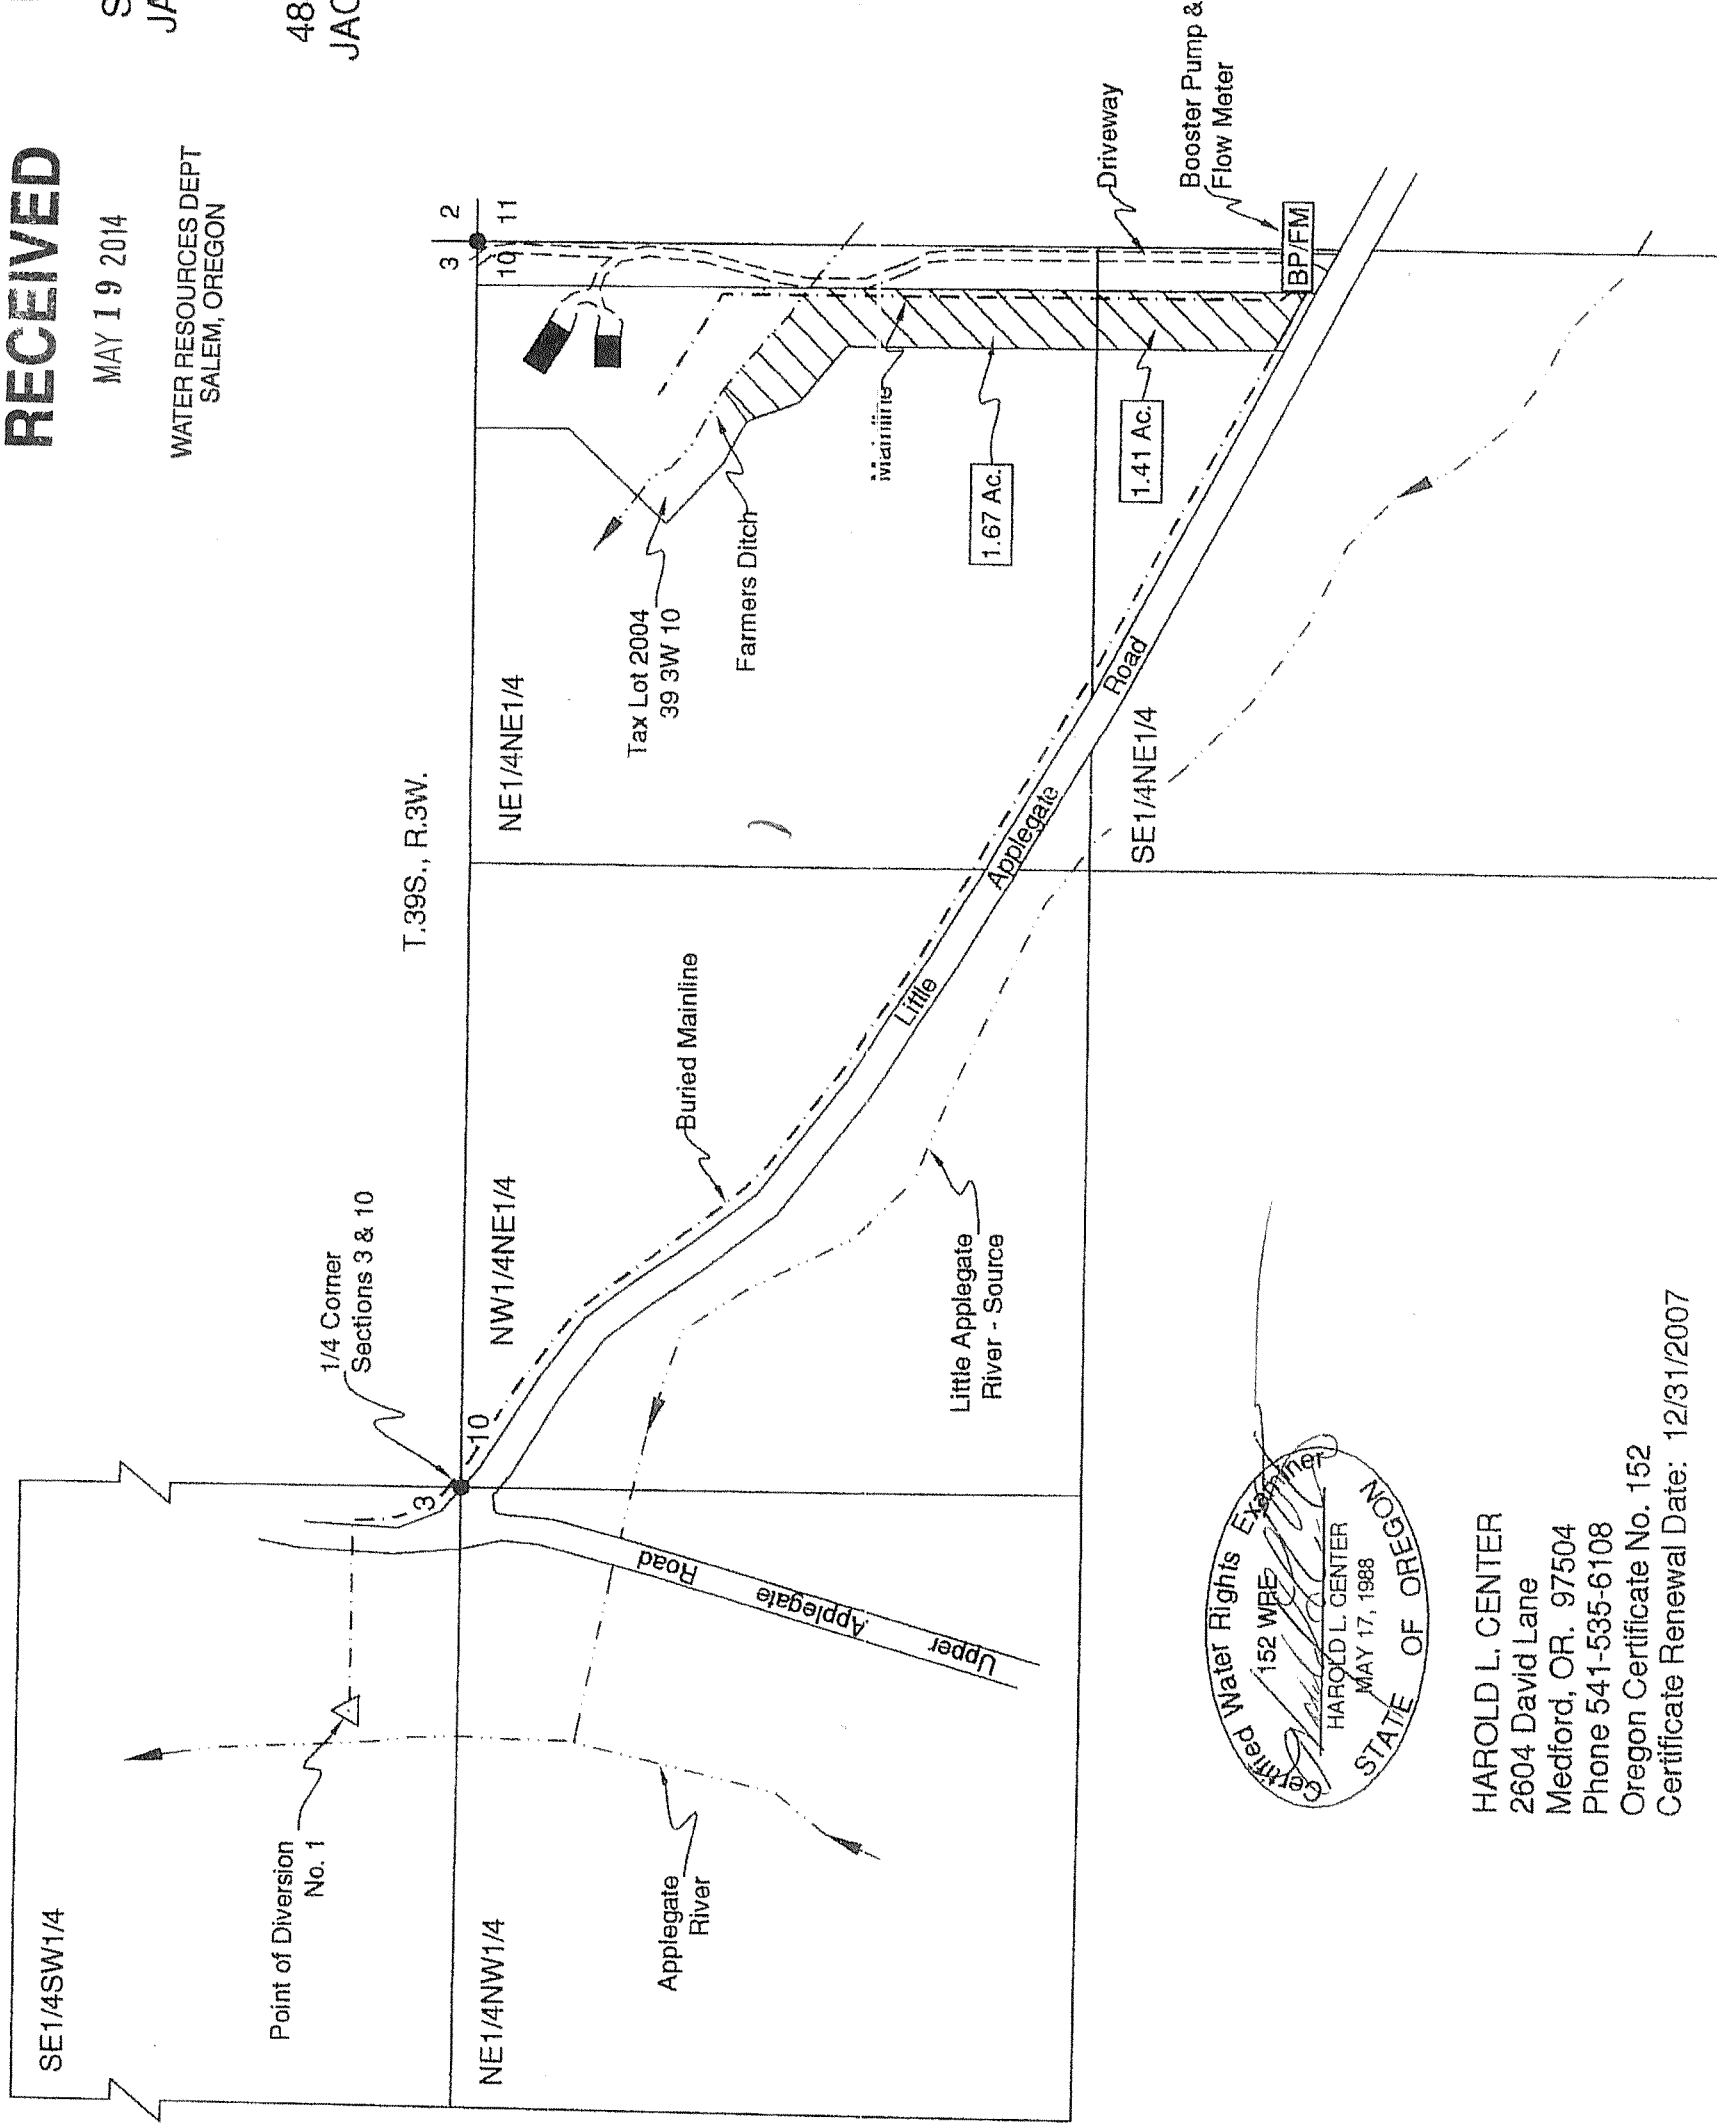

Point of Diversion No. 1 - Situated 480' West and 230' North of South One-Quarter Corner, Section 3. Fish Screen at Point of Diversion.

This map was prepared for the purpose of identifying the location of a water right only and is not intended to provide legal dimensions or location of property ownership.

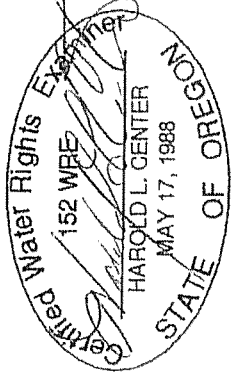

HAROLD L. CENTER
2604 David Lane
Medford, OR. 97504
Phone 541-535-6108
Oregon Certificate No. 152
Certificate Renewal Date: 12/31/2007