


CLAIM OF BENEFICIAL USE MAP UNDER PERMIT R-14832

T 39 S, R 3 E, WM, JACKSON COUNTY

SE1/4 Section 20

October 24, 2010

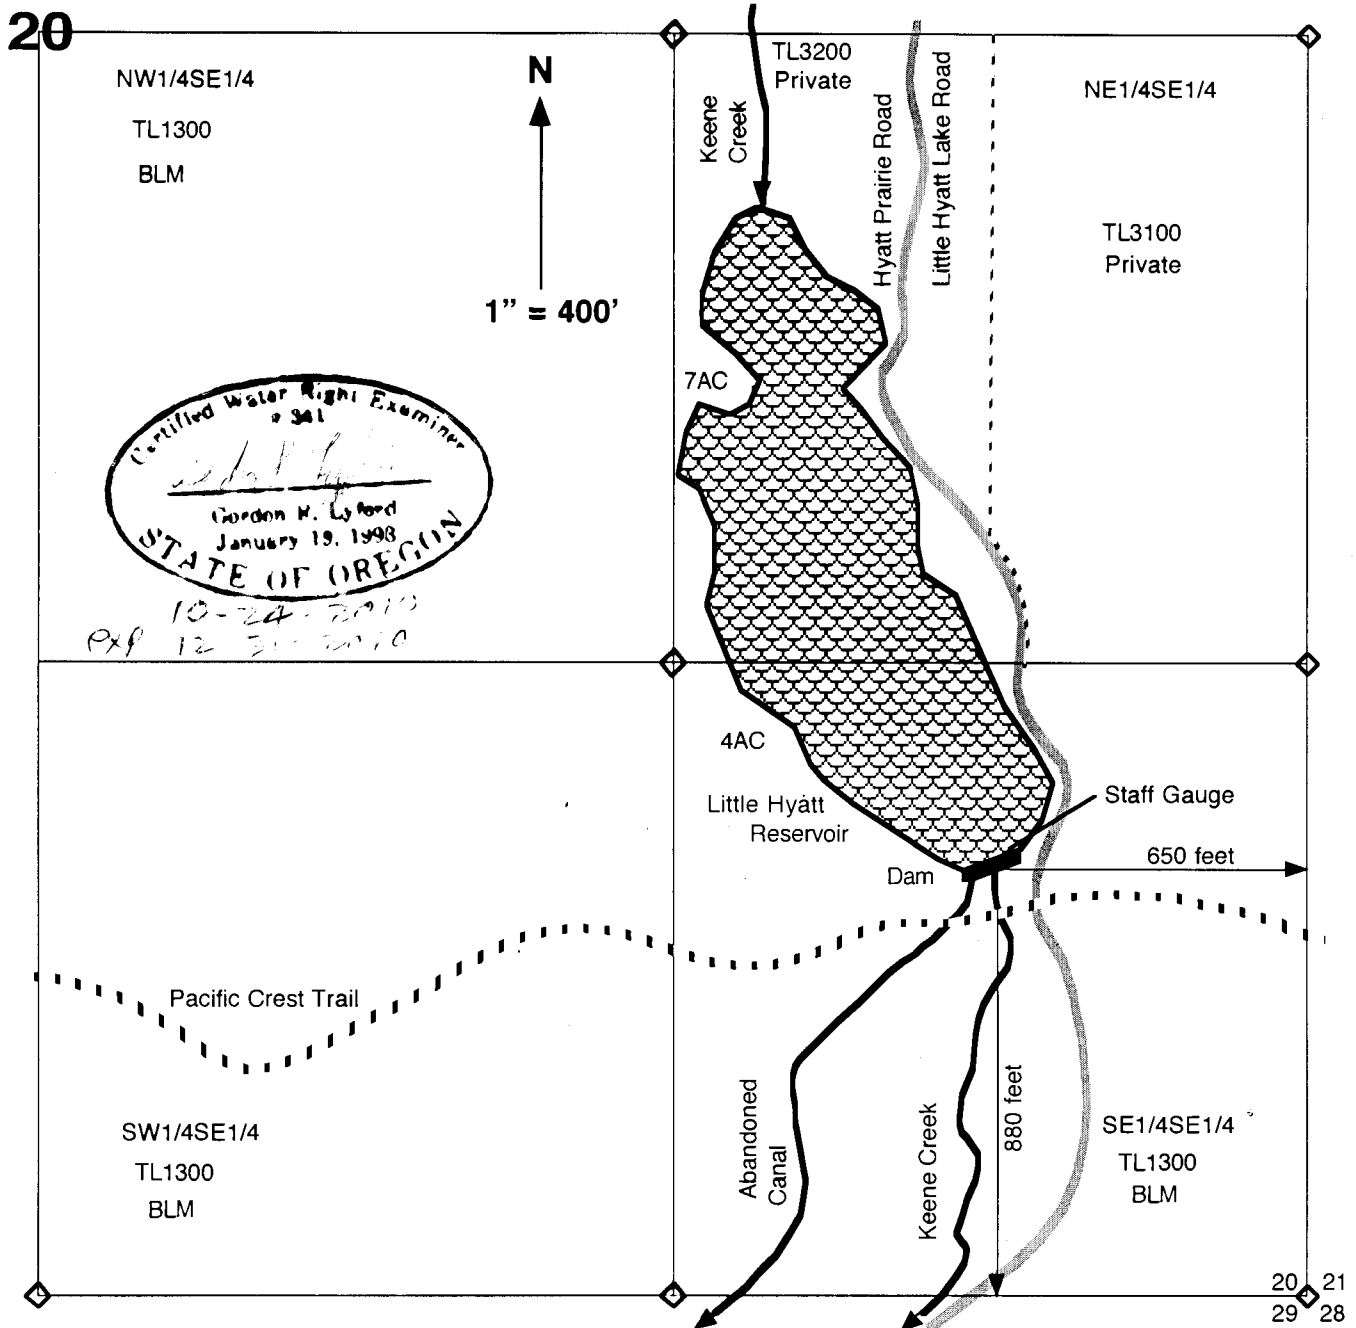

Little Hyatt Reservoir under application R-85751 and permit R-14832 has a storage priority of August 25, 2003, and when full has a surface area of 11 acres, a maximum depth of 16 feet, and a volume of 59 acre-feet.

This map was drawn by Gordon R. Lyford for the Bureau of Land Management Medford District to support their Claim of Beneficial Use for a reservoir on Keene Creek storing water for aesthetics, recreation, and wildlife uses. The BLM administers tax lot 1300.

This map was prepared for the purpose of identifying the location of water rights only and is not intended to provide legal dimensions or the location of property ownership lines.