


RECEIVED

CLERK OF DISTRICT
WATER RIGHTS DIVISION
ALBANY, OREGON

FINAL PROOF SURVEY
FOR
OTTER ROCK WATER DISTRICT
WRD FILE #T-7118
SEPTEMBER 1997
SECTION 32 T.9S. R.11 W - W.M.

SPRING LOCATIONS BASED ON INFORMATION PROVIDED BY JON SUENNINGSON,
OREGON COAST ENGINEERS FOR OTTER ROCK WATER DISTRICT. ALSO
SEE COUNTY SURVEY #13,754 (DONE BY SUENNINGSON FOR O.R.W.D.)

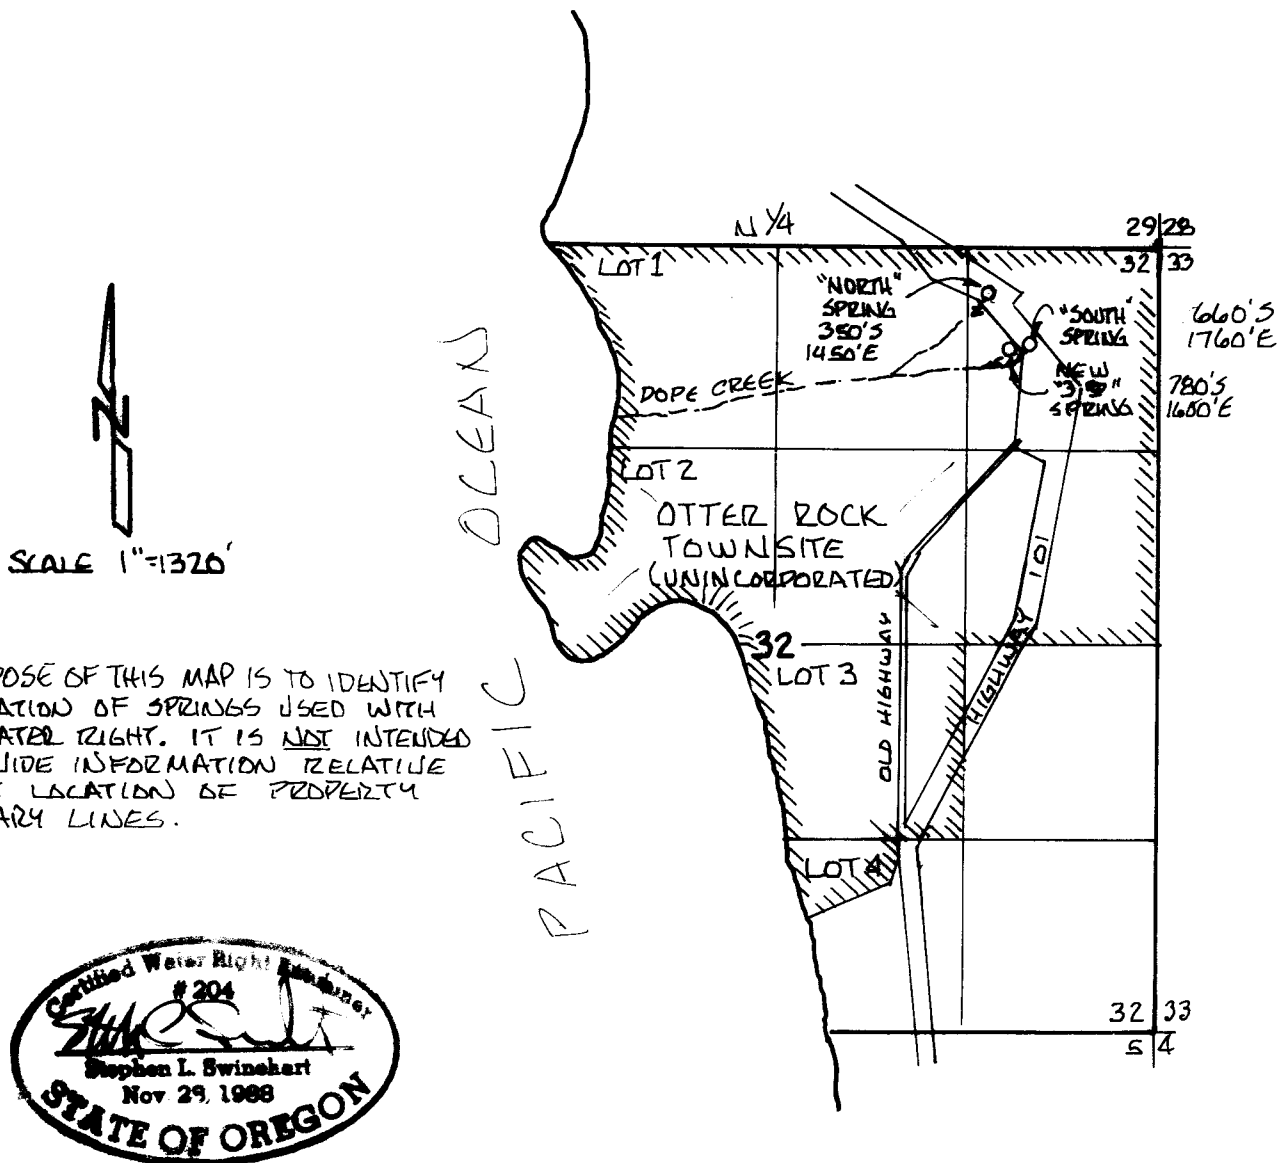

NOTE:

THE PURPOSE OF THIS MAP IS TO IDENTIFY
THE LOCATION OF SPRINGS USED WITH
THIS WATER RIGHT. IT IS NOT INTENDED
TO PROVIDE INFORMATION RELATIVE
TO THE LOCATION OF PROPERTY
BOUNDARY LINES.



RENEWAL: 6/30/98
- REVISED 5/8/05 -
Added Township & Range,
Revised mailing address

PREPARED BY
SWINEHART LAND SURVEYING
P.O. BOX 605 SI PIONEER TRAIL
TOLEDO HEMPST, OREGON
(541) 336-3739