


RECEIVED

JUL 21 2005

WATER RESOURCES DEPT
SALEM, OREGON

FINAL PROOF SURVEY
FOR
OTTER ROCK WATER DISTRICT
WRD FILE #T-7118
SEPTEMBER 1997
SECTION 32 T.9S. R.11 W - W.M.

SPRING LOCATIONS BASED ON INFORMATION PROVIDED BY SON SUENNINGSON,
OREGON COAST ENGINEERS FOR OTTER ROCK WATER DISTRICT. ALSO
SEE COUNTY SURVEY #13,754 (DONE BY SUENNINGSON FOR O.R.W.D.)

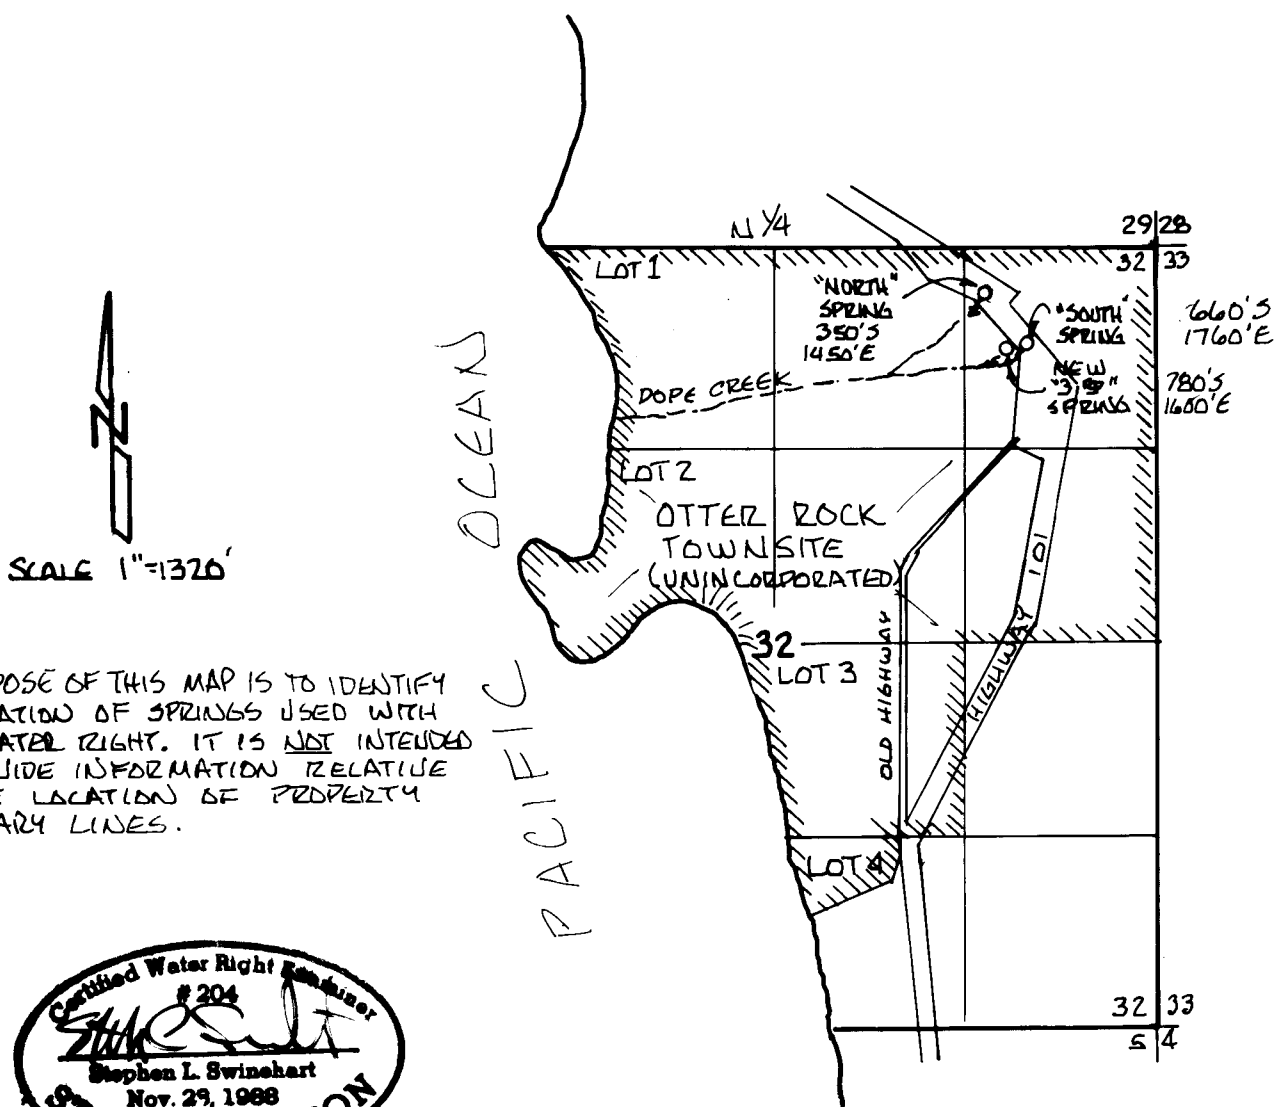

RENEWAL: 6/30/98
- Revised 5/8/05 -
Added Township & Range,
Revised mailing address

PREPARED BY
SWINEHART LAND SURVEYING
P.O. BOX 605 S1 PIONEER TRAIL
TOLEDO HARBOR, OREGON
(541) 336-3739