## RECEIVED


## CLAIM OF BENEFICIAL USE MAP TRANSFER: T-8020 FOR GOLDEN RULE FARMS

FEB 04 2004

WATER RESOURCES DEPT SALEM OREGON

## HATCH LEGEND

LOCATED IN A PORTION OF SECTIONS 20 AND 29 TOWNSHIP 27 SOUTH, RANGE 17 EAST, W.M., LAKE COUNTY, OREGON

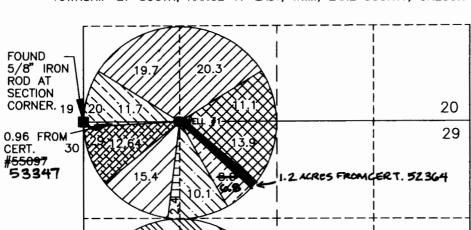

40.0 ACRES FROM CERTIFICATE #53453 BEING IRRIGATED.

25.0 ACRES FROM CERTIFICATE #27315 BEING IRRIGATED.

8.0 ACRES FROM CERTIFICATE #52631 BEING IRRIGATED.

10.1 ACRES FROM CERTIFICATE #51770 BEING IRRIGATED.

35.0 ACRES FROM CERTIFICATE #55097 BEING IRRIGATED.


15.4 ACRES FROM CERTIFICATE #53348 BEING IRRIGATED.

11.7 12.66 ACRES FROM CERTIFICATE #53347 BEING IRRIGATED.

13.6 12.64 ACRES FROM CERTIFICATE #53347 BEING IRRIGATED.

58.0 ACRES FROM CERTIFICATE #55097 BEING IRRIGATED.

> 35.0 ACRES FROM CERTIFICATE #55098 BEING IRRIGATED.

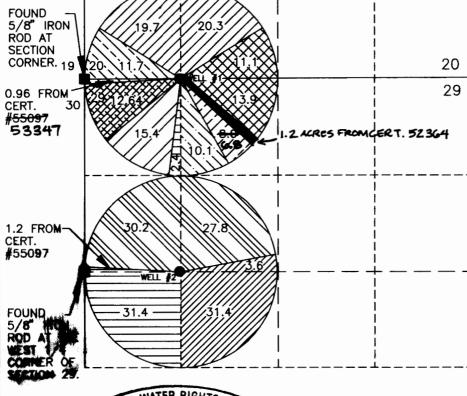



SCALE 1"=1320'

THIS MAP IS FOR THE PURPOSE OF LOCATING A WATER RIGHT AND HAS NO INTENT TO PROVIDE LEGAL DIMENSIONS OR THE LOCATION OF PROPERTY LINES.

## LEGEND

28

- FOUND LAND SURVEY MONUMENT AS NOTED.
- WELL #1. POINT OF APPROPRIATION, EXISTING WELL, LOCATED IN THE SW1/4SW1/4 OF SECTION 20 AND LOCATED 5 FEET NORTH AND 1306 FEET EAST FROM THE SOUTHWEST CORNER OF SECTION 20.
- WELL #2. POINT OF APPROPRIATION, EXISTING WELL, LOCATED IN THE SW1/4NW1/4 OF SECTION 29 AND LOCATED 6 FEET NORTH AND 1303 FEET EAST FROM THE WEST 1/4 CORNER OF SECTION 29.

PREPARED FOR: GOLDEN RULE FARMS, INC.

P.O. BOX 255

CHRISTMAS VALLEY, OR 97641

PREPARED BY:

CALLAGHAN LAND SURVEYING 427 SOUTH H STREET LAKEVIEW, OR 97630 (541) 947-5841

DATE: 8/27/2003 DRAWING: 200356