

RECEIVED


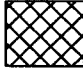








FEB 04 2004



CLAIM OF BENEFICIAL USE MAP  
TRANSFER: T-8020  
FOR  
GOLDEN RULE FARMS

WATER RESOURCES DEPT  
SALEM OREGON

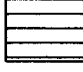HATCH LEGEND

LOCATED IN A PORTION OF SECTIONS 20 AND 29  
TOWNSHIP 27 SOUTH, RANGE 17 EAST, W.M., LAKE COUNTY, OREGON

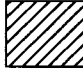-  40.0 ACRES FROM CERTIFICATE #53453 BEING IRRIGATED.
-  25.0 ACRES FROM CERTIFICATE #27315 BEING IRRIGATED.
-  ~~8.0~~ <sup>6.8</sup> ACRES FROM CERTIFICATE #52631 BEING IRRIGATED.
-  10.1 ACRES FROM CERTIFICATE #51770 BEING IRRIGATED.
-  35.0 ACRES FROM CERTIFICATE #55097 BEING IRRIGATED.
-  15.4 ACRES FROM CERTIFICATE #53348 BEING IRRIGATED.
-  11.7 ~~12.66~~ ACRES FROM CERTIFICATE #53347 BEING IRRIGATED.
-  ~~12.64~~ <sup>13.6</sup> ACRES FROM CERTIFICATE #53347 BEING IRRIGATED.
-  58.0 ACRES FROM CERTIFICATE #55097 BEING IRRIGATED.
-  35.0 ACRES FROM CERTIFICATE #55098 BEING IRRIGATED.

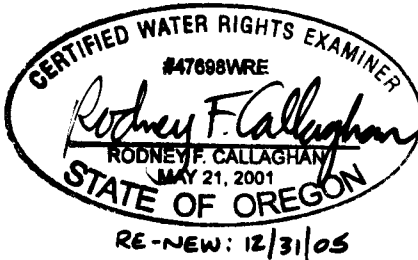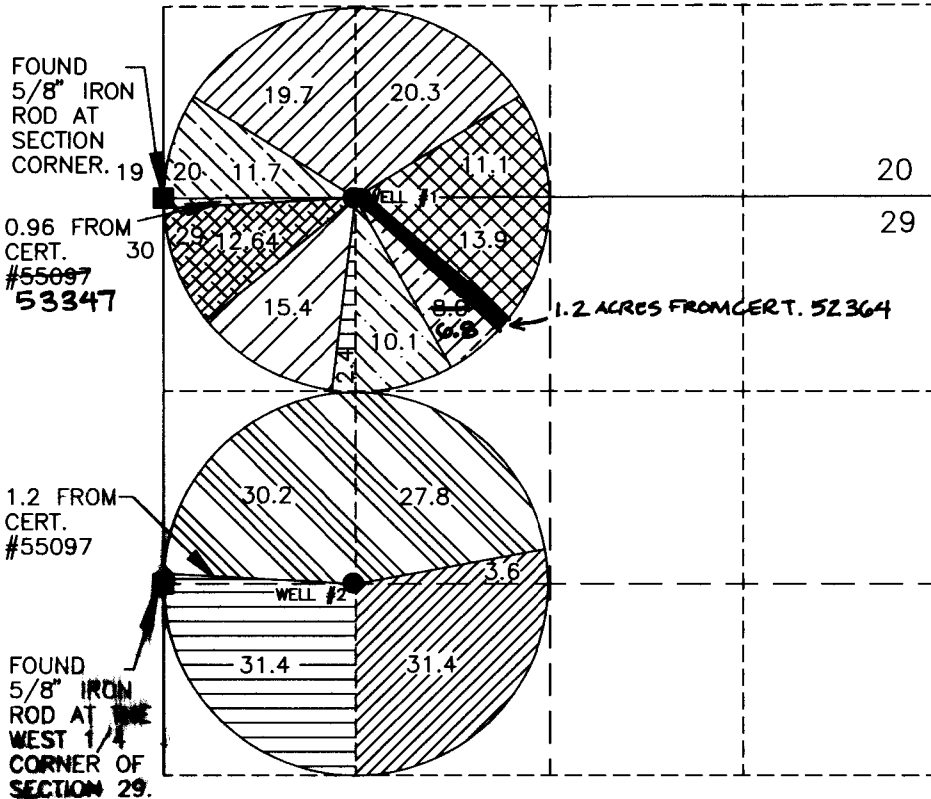

SCALE 1"=1320'

THIS MAP IS FOR THE PURPOSE OF LOCATING A WATER RIGHT AND HAS NO INTENT TO PROVIDE LEGAL DIMENSIONS OR THE LOCATION OF PROPERTY LINES.

LEGEND

- FOUND LAND SURVEY MONUMENT AS NOTED.
- WELL #1. POINT OF APPROPRIATION, EXISTING WELL, LOCATED IN THE SW1/4SW1/4 OF SECTION 20 AND LOCATED 5 FEET NORTH AND 1306 FEET EAST FROM THE SOUTHWEST CORNER OF SECTION 20.
- WELL #2. POINT OF APPROPRIATION, EXISTING WELL, LOCATED IN THE SW1/4NW1/4 OF SECTION 29 AND LOCATED 6 FEET NORTH AND 1303 FEET EAST FROM THE WEST 1/4 CORNER OF SECTION 29.

PREPARED FOR: GOLDEN RULE FARMS, INC.  
P.O. BOX 255  
CHRISTMAS VALLEY, OR 97641

PREPARED BY:

CALLAGHAN LAND SURVEYING  
**CLS** 427 SOUTH H STREET  
LAKEVIEW, OR 97630  
(541) 947-5841

DATE: 8/27/2003 DRAWING: 200356

This map has been revised by WRD to reflect certificate mislabeling and acreage mislabeling. Joy/wkd 10/1/15