

RECEIVED




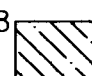

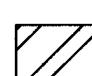


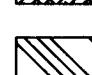

FEB 04 2004

CLAIM OF BENEFICIAL USE MAP
TRANSFER: T-8020
FOR
GOLDEN RULE FARMS

WATER RESOURCES DEPT
SALEM, OREGON

HATCH LEGEND

LOCATED IN A PORTION OF SECTIONS 20 AND 29
TOWNSHIP 27 SOUTH, RANGE 17 EAST, W.M., LAKE COUNTY, OREGON

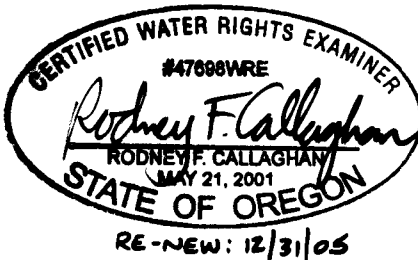
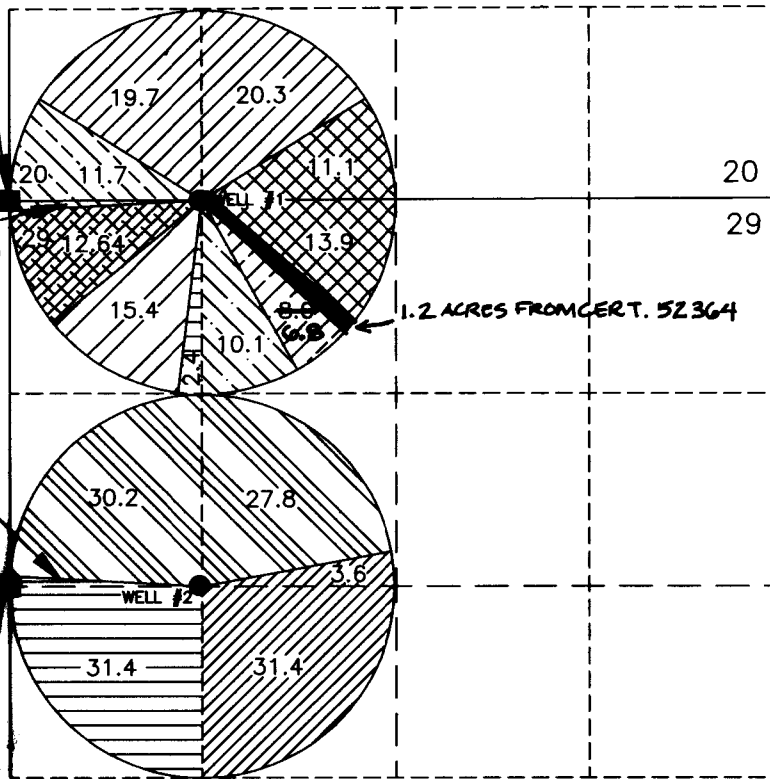
-  40.0 ACRES FROM CERTIFICATE #53453 BEING IRRIGATED.
-  25.0 ACRES FROM CERTIFICATE #27315 BEING IRRIGATED.
-  ~~8.0~~ 6.8 ACRES FROM CERTIFICATE #52631 BEING IRRIGATED.
-  10.1 ACRES FROM CERTIFICATE #51770 BEING IRRIGATED.
-  35.0 ACRES FROM CERTIFICATE #55097 BEING IRRIGATED.
-  15.4 ACRES FROM CERTIFICATE #53348 BEING IRRIGATED.
-  11.7 ~~12.66~~ ACRES FROM CERTIFICATE #53347 BEING IRRIGATED.
-  13.6 ~~12.64~~ ACRES FROM CERTIFICATE #53347 BEING IRRIGATED.
-  58.0 ACRES FROM CERTIFICATE #55097 BEING IRRIGATED.
-  35.0 ACRES FROM CERTIFICATE #55098 BEING IRRIGATED.

FOUND 5/8" IRON ROD AT SECTION CORNER. 19

0.96 FROM CERT. #55097 53347

1.2 FROM CERT. #55097

FOUND 5/8" IRON ROD AT WEST CORNER OF SECTION 29.



LEGEND

- FOUND LAND SURVEY MONUMENT AS NOTED.
- WELL #1. POINT OF APPROPRIATION, EXISTING WELL, LOCATED IN THE SW1/4SW1/4 OF SECTION 20 AND LOCATED 5 FEET NORTH AND 1306 FEET EAST FROM THE SOUTHWEST CORNER OF SECTION 20.
- WELL #2. POINT OF APPROPRIATION, EXISTING WELL, LOCATED IN THE SW1/4NW1/4 OF SECTION 29 AND LOCATED 6 FEET NORTH AND 1303 FEET EAST FROM THE WEST 1/4 CORNER OF SECTION 29.

SCALE 1"=1320'

THIS MAP IS FOR THE PURPOSE OF LOCATING A WATER RIGHT AND HAS NO INTENT TO PROVIDE LEGAL DIMENSIONS OR THE LOCATION OF PROPERTY LINES.

PREPARED FOR: GOLDEN RULE FARMS, INC.
P.O. BOX 255
CHRISTMAS VALLEY, OR 97641

PREPARED BY:

CALLAGHAN LAND SURVEYING
427 SOUTH H STREET
LAKEVIEW, OR 97630
(541) 947-5841

DATE: 8/27/2003

DRAWING: 200356

This map has been revised by WRD to reflect certificate mislabeling and acreage mislabeling. Joye/wkd 10/1/15