



Claim of Beneficial Use

In The Name of
Michael and Cheryl Snook

T26S-R6W-S25AA
Tax Lot: 1100


Application: S-86258
Permit: S-54257

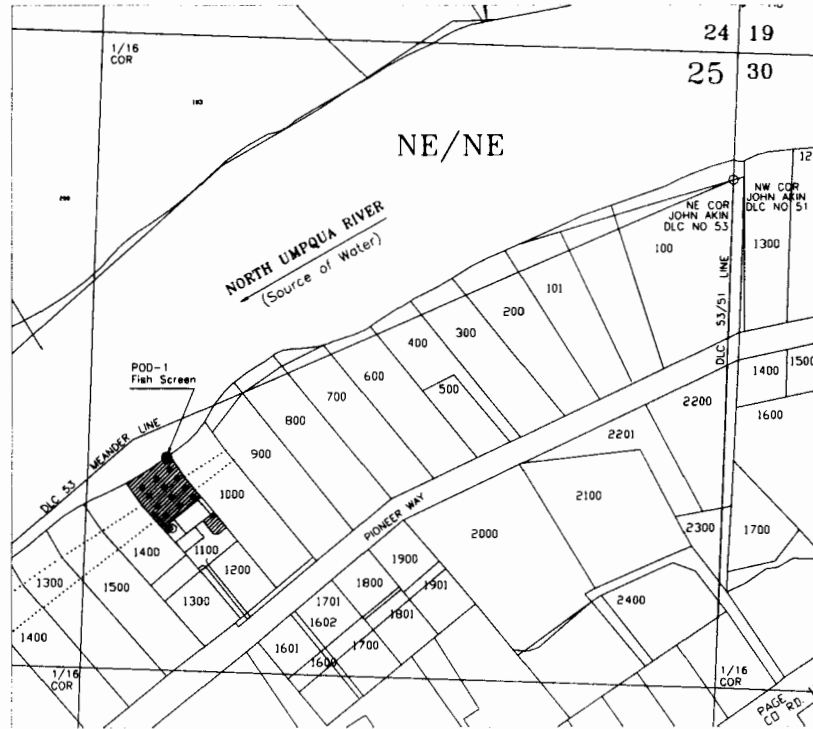

 IRRIGATION: 0.308 ACRE
Within NE/NE of Sec 25, DLC 53

- POD-1 & Fish Screen
- Pop-up sprinkler heads (13) } Buried system info lost to
— Drip system } previous owner/installer.
- Hose bib

POD-1 & Fish Screen: Per river meander location more or less 840 feet South and 1,183 feet West from the NE corner of Section 25, common with 30, 19 & 24. Within DLC 53.

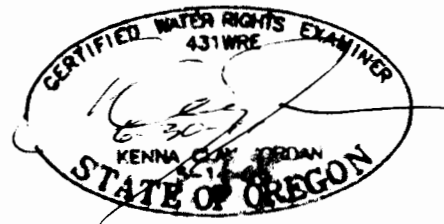

1" = 400'

This map is not intended to provide legal dimensions and/or locations of property ownership lines.

Locations per 1/4 1/4 are derived by assumed fit of aerial photo orientation to ground surveys and/or tax assessor maps.

JORDAN ENGINEERING
460 JORDAN LANE
ROSEBURG, OREGON 97471
(541) 673-1931

08-09-10