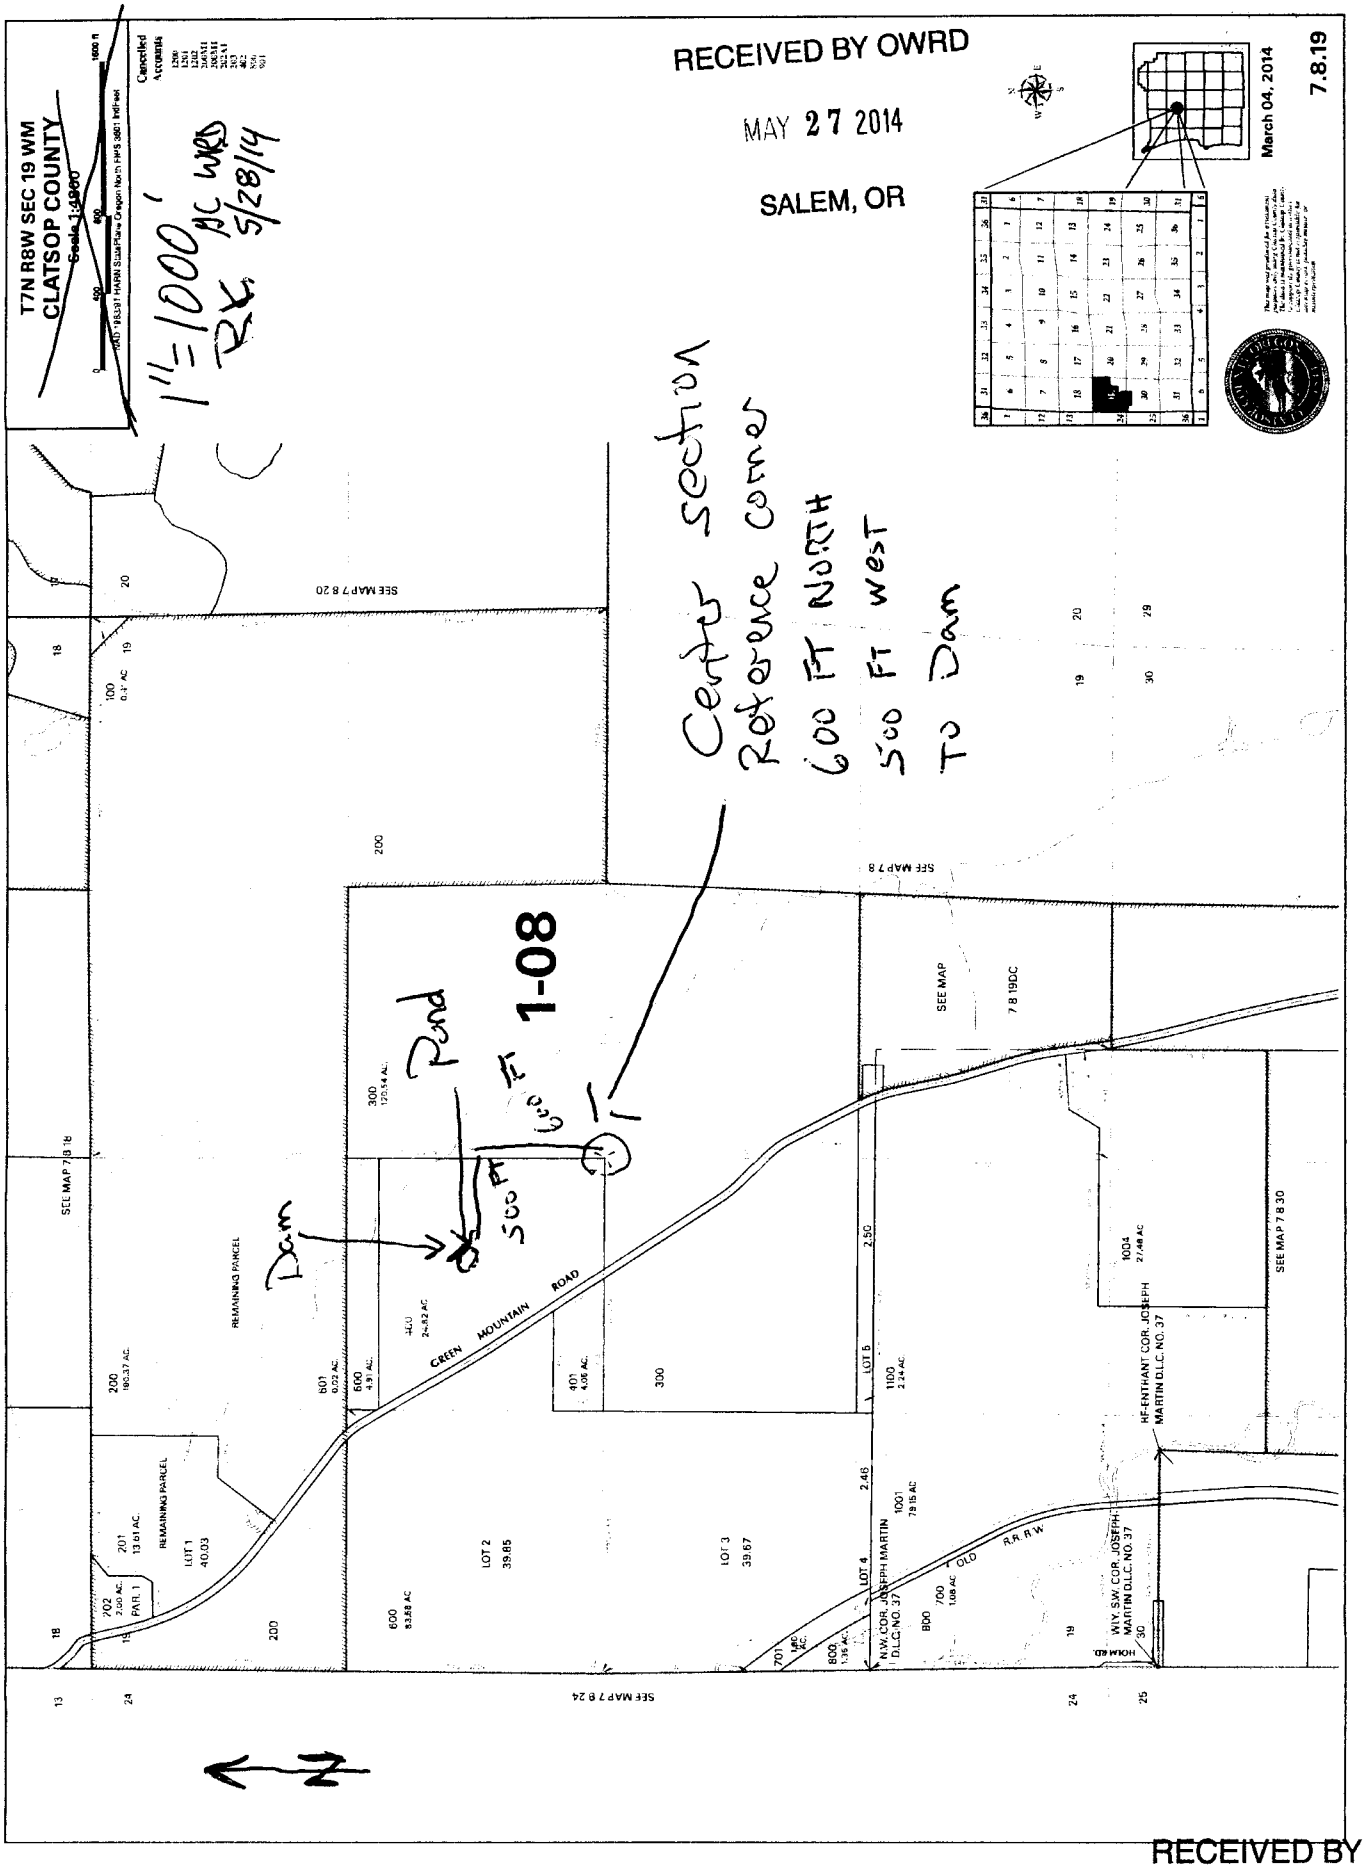

RECEIVED BY OWRD

JUN 05 2014

SALEM, OR

R-87982

Permit R-15077