


T8S, R46E, Section 3, Willamette Meridian

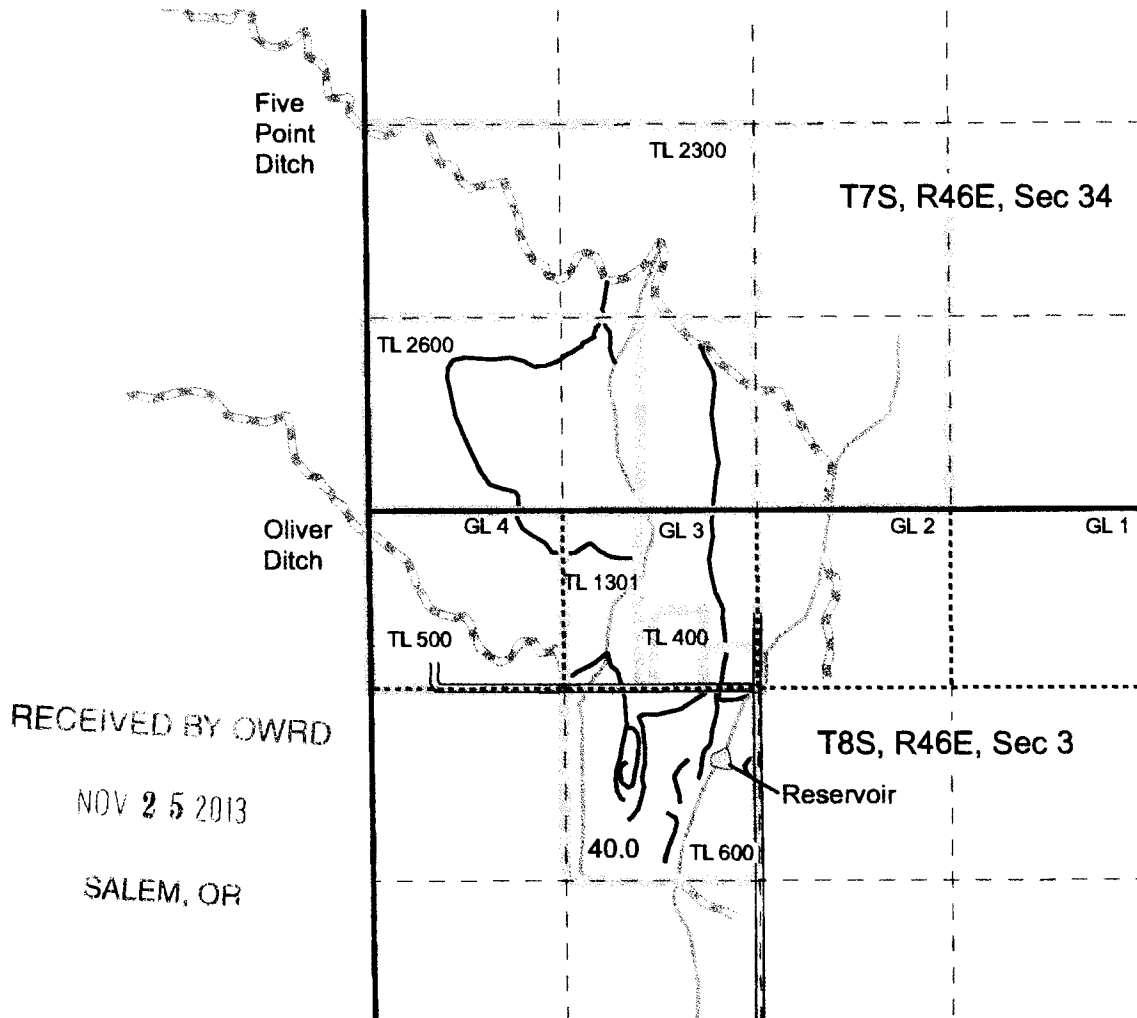

RECEIVED BY OWRD

NOV 25 2013

SALEM, OR

- == Roads
- Government lot line
- - - Quarter quarter
- Section line
- tax lot lines
- Reservoir
- Ditch
- Lateral ditch
- Stream

0 660 1,320 Feet

1 inch = 1,320 feet



This map is not intended to provide legal dimensions or locations of property ownership lines.

Prepared by
Nancy Rorick Consulting

Claim of Beneficial Use Map for Reservoirs storing less than 9.2 acre feet
Application R87286 and Permit R14717
James M. Young, Tax lot 600