


T. 26 S., R. 28 E., W.M.

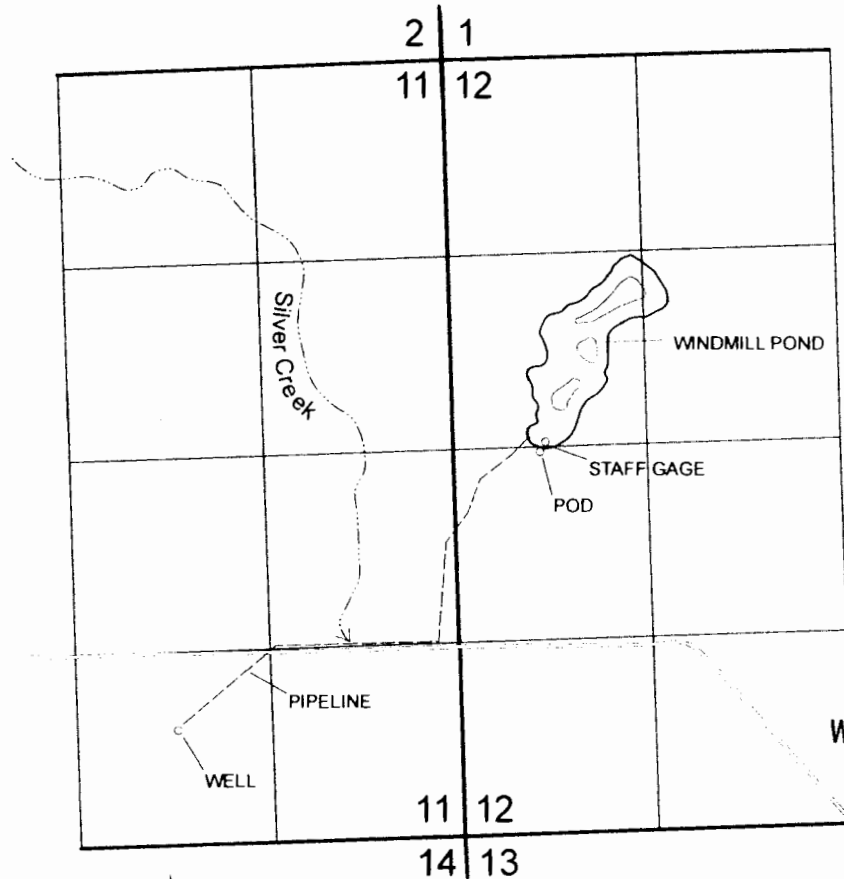

**RECEIVED**

DEC 05 2008

WATER RESOURCES DEPT  
SALEM, OREGON

OREGON STATE PLANE GRID NORTH  
(SOUTH ZONE,  $\theta = + 0^{\circ} 51' 3.7''$ )

1 INCH = 1320 FEET

WELL IS LOCATED 715 FT NORTH AND  
1975 FT WEST FROM THE SE CORNER  
OF SECTION 11, BEING WITHIN THE  
SW $\frac{1}{4}$  SE $\frac{1}{4}$  OF SECTION 11.

POD IS LOCATED 2615 FT NORTH AND  
520 FT EAST FROM THE SW CORNER  
OF SECTION 12, BEING WITHIN THE  
NW $\frac{1}{4}$  SW $\frac{1}{4}$  OF SECTION 12.

## FINAL PROOF SURVEY


UNDER

Application No. R-85283 Permit No. R-13693

Application No. G-15833 Permit No. G-15490

IN THE NAME OF

**U.S. FISH & WILDLIFE SERVICE  
(MALHEUR NWR - WINDMILL POND)**

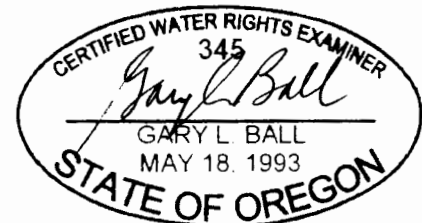

RENEWS: 12/31/2009

This map is not intended to provide  
legal dimensions or locations of  
property ownership lines.