


# T9S, R3W, WM

MARION COUNTY

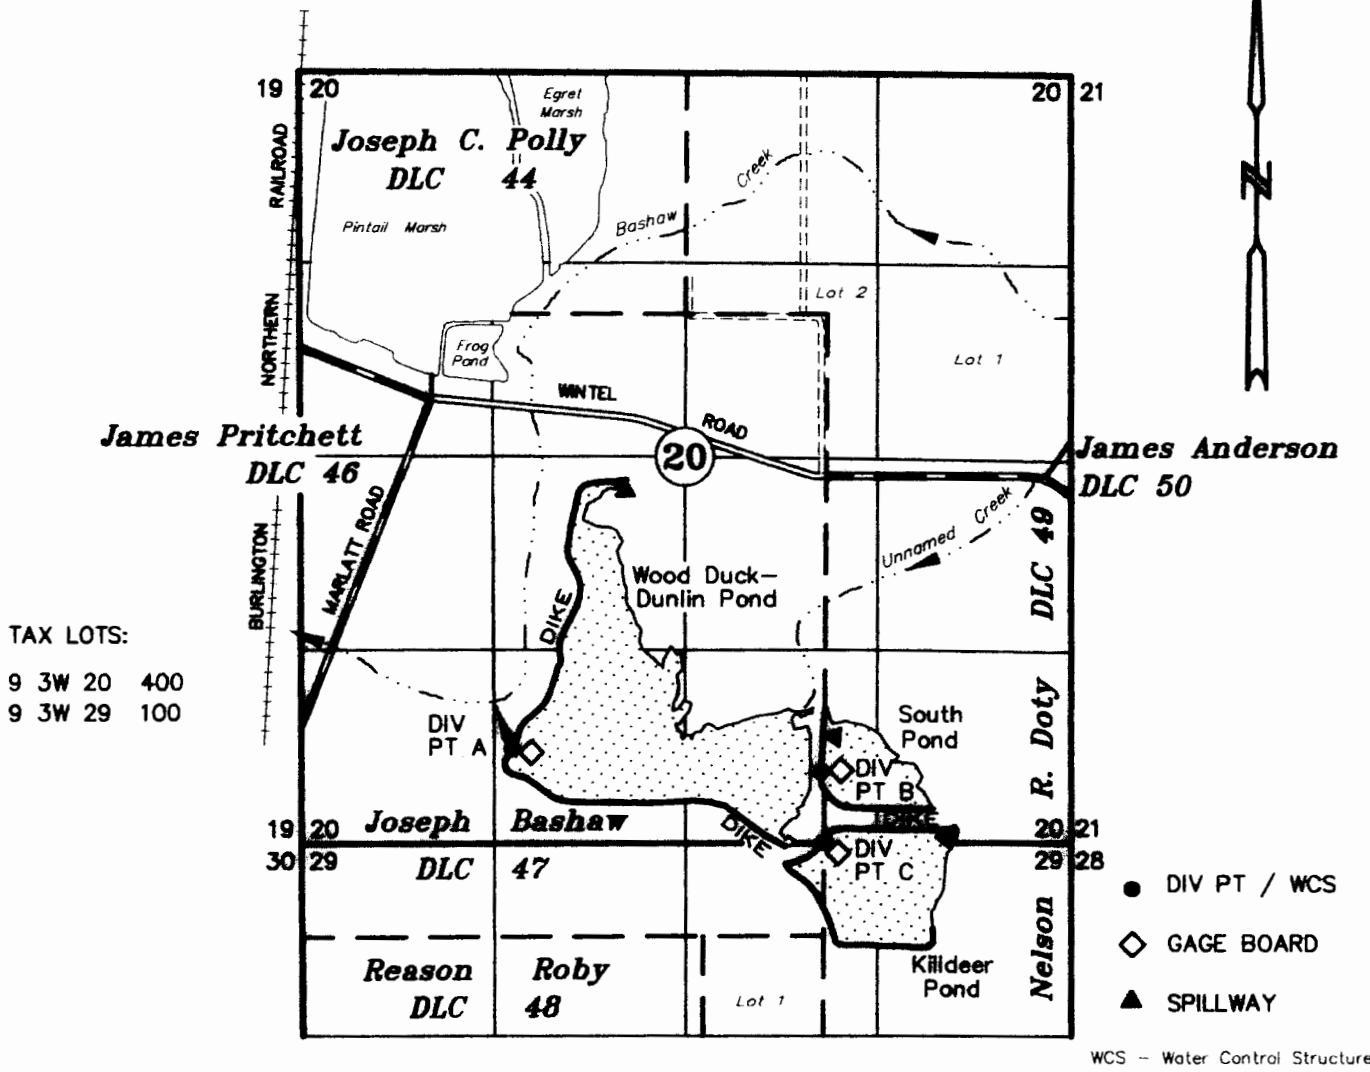

DIV PT A, WOOD DUCK - DUNLIN POND: 2380' SOUTH & 557' EAST OF NE COR JAMES PRITCHETT DLC No 46  
 DIV PT B, SOUTH POND: 2535' SOUTH & 2696' EAST OF NE COR JAMES PRITCHETT DLC No 46  
 DIV PT C, KILLDEER POND: 3022' SOUTH & 2692' EAST OF NE COR JAMES PRITCHETT DLC No 46

## FINAL PROOF SURVEY

UNDER

Application No. R-83835 Permit No. R-12112


## U.S. FISH & WILDLIFE SERVICE

Division of Engineering

JULY 10, 2007

June 23, 2009

SCALE: 1" = 1320'

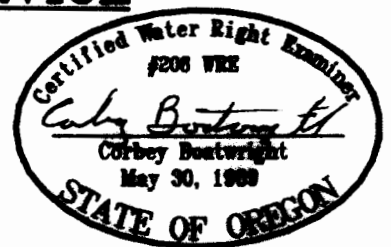

NOTE: This map is for the purpose of identifying the location of water rights and has no intent to dimension or locate property ownership lines.

EXPIRES: 12-31-2011