# T9S, R3W, WM

MARION COUNTY

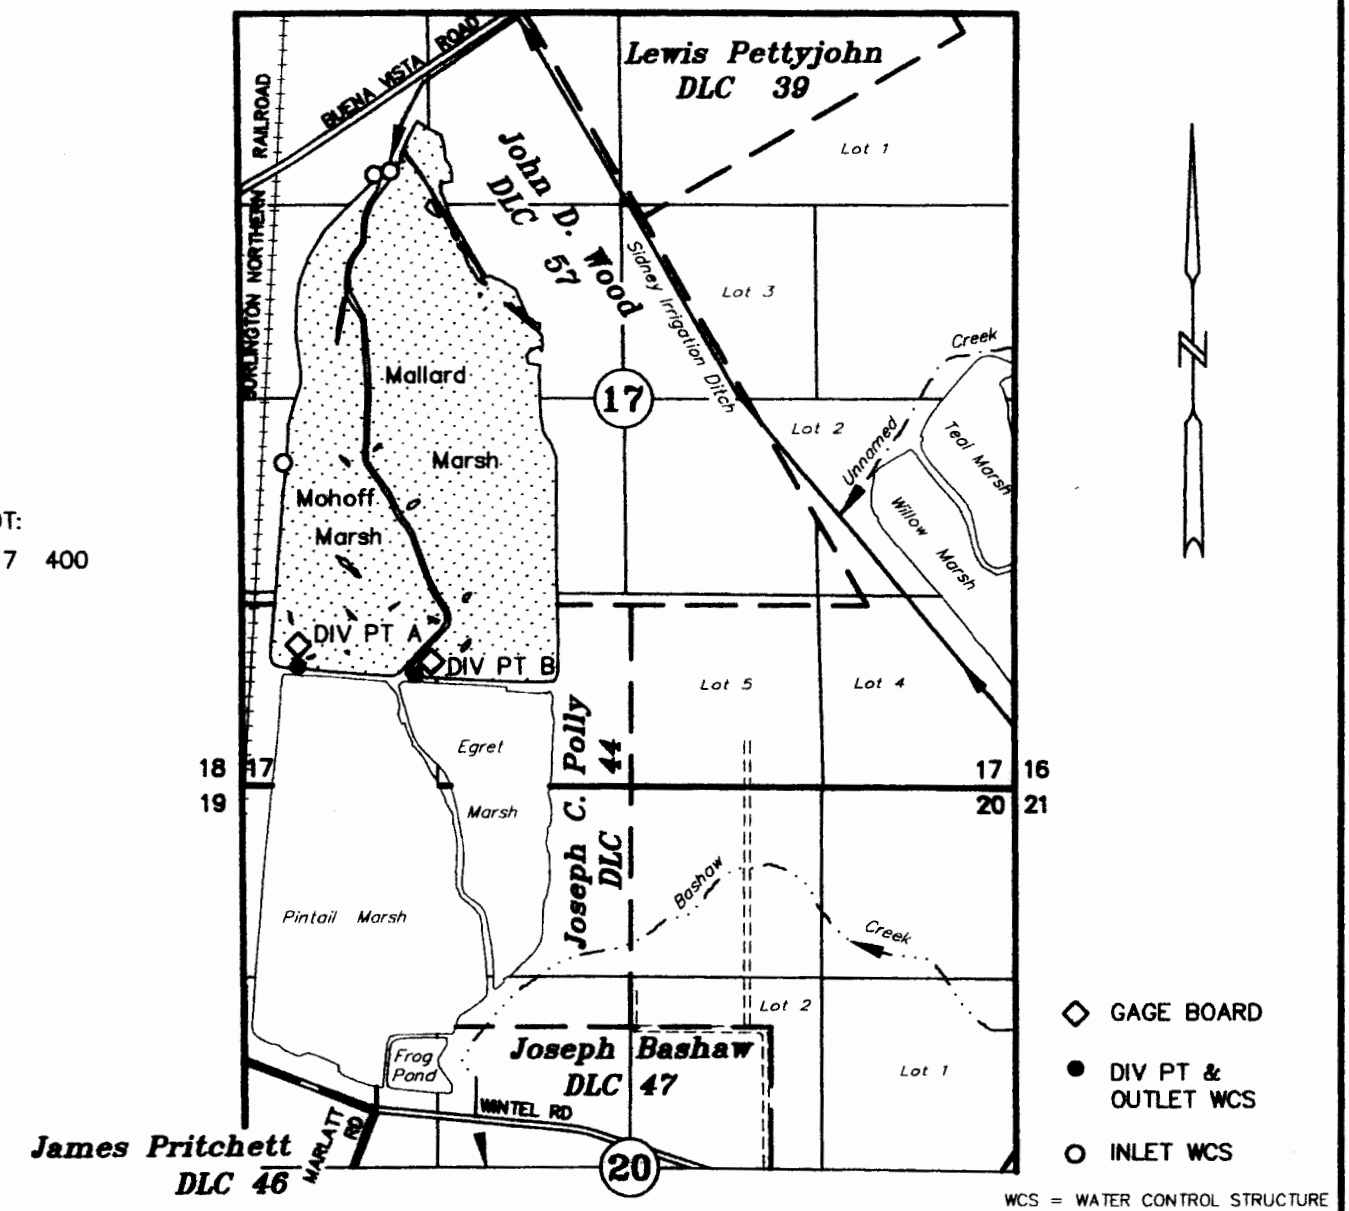


TAX LOT:
9 3W 17 400

WCS = WATER CONTROL STRUCTURE

DIV PT A, MOHOFF MARSH: 3044' NORTH & 443' WEST OF NE COR JAMES PRITCHETT DLC No 46
DIV PT B, MALLARD MARSH: 2963' NORTH & 304' EAST OF NE COR JAMES PRITCHETT DLC No 46

# FINAL PROOF SURVEY

UNDER

Application No. T-7583 R-80134 Permit No. SP ORD 51-1052 R-12203

## U.S. FISH & WILDLIFE SERVICE

### Division of Engineering

NOVEMBER 23, 2009

SCALE: 1" = 1320'

Certified Water Right Examiner
#208 WRE
Corbey Boatwright
Corbey Boatwright
May 30, 1989
STATE OF OREGON

NOTE: This map is for the purpose of identifying the location of water rights and has no intent to dimension or locate property ownership lines.

EXPIRES: 12-31-2011