
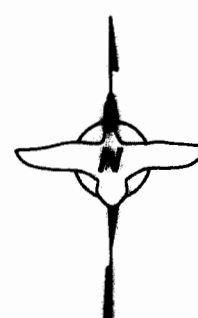


T. 2 S., R. 2 W., W.M.

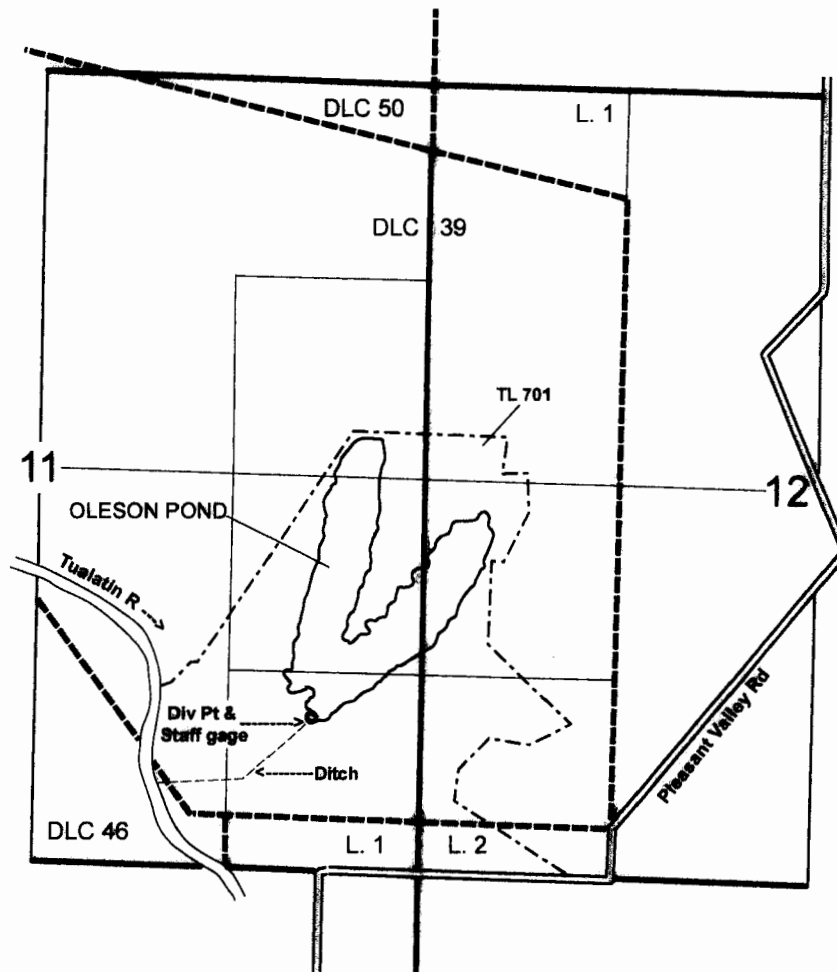

OREGON STATE PLANE
GRID NORTH
(NORTH ZONE, $\theta = -1.7^\circ$)
1 INCH = 1320 FEET

FINAL PROOF SURVEY APPLICATION R-86279, PERMIT R-14372 IN THE NAME OF U.S. FISH & WILDLIFE SERVICE

THE DIVERSION POINT IS LOCATED 1040 FEET NORTH AND 740 FEET WEST FROM THE SE CORNER OF SECTION 11, BEING WITHIN THE SE $\frac{1}{4}$ SE $\frac{1}{4}$ SECTION 11, AS PROJECTED WITHIN DLC 39.

THIS MAP IS NOT INTENDED TO PROVIDE LEGAL DIMENSIONS OR LOCATIONS OF PROPERTY OWNERSHIP LINES



RENEWS: 12/31/2011