


FINAL PROOF MAP

IN THE NAME OF DAVID T. & JUDITH A.S. CHAPMAN
Application G-13094 Permit G-12115
T 5 S, R 2 E, W.M. Section 14

06/07/2010

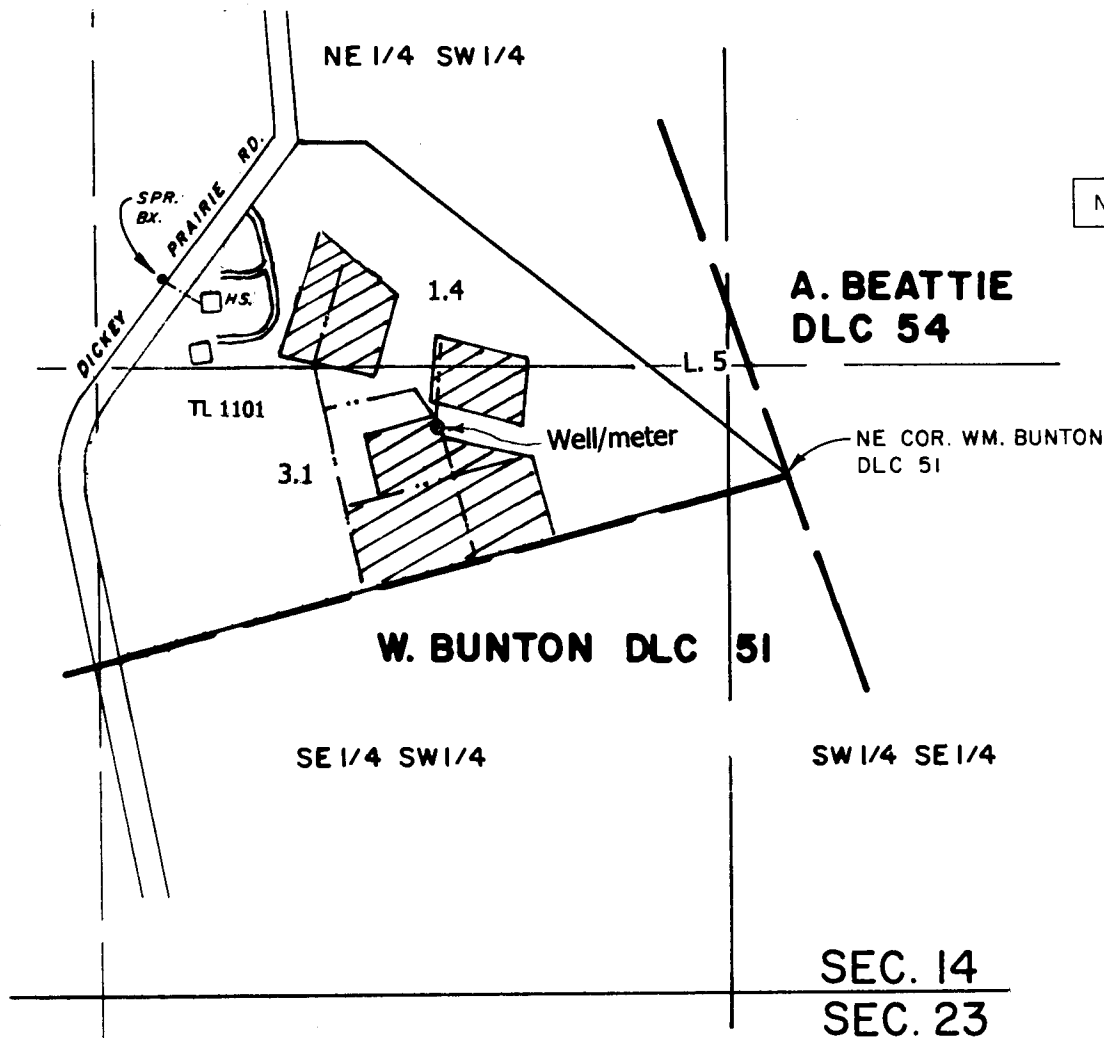


- DLC line
- Section line
- Pipe line
- Tax Lot Boundary
- 1/4 1/4 line

DIVERSION POINT: 105' N & 720' W
from the NE Corner DLC 51

Scale 1" = 400'

This map is not intended to provide legal
dimensions or locations of property ownership lines .

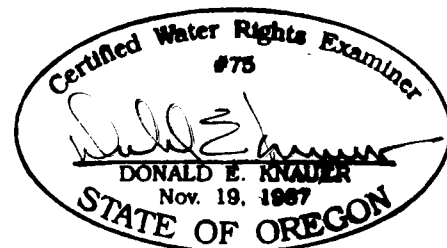

RENEWAL DATE: 6/30/2011