



Polk County Map

9.5.5

- CntlMap
- cntlarc
- cntlmap
- DLC
- Railroad
- Roads
- GRAVEL
- Section
- Subdivision
- Taxlot14
- Taxlot Arrows14
- Taxlot Boundary14
- taxlot14
- TaxMap
- 2
- 32
- 33
- 34
- 47
- 7
- 8
- Updates

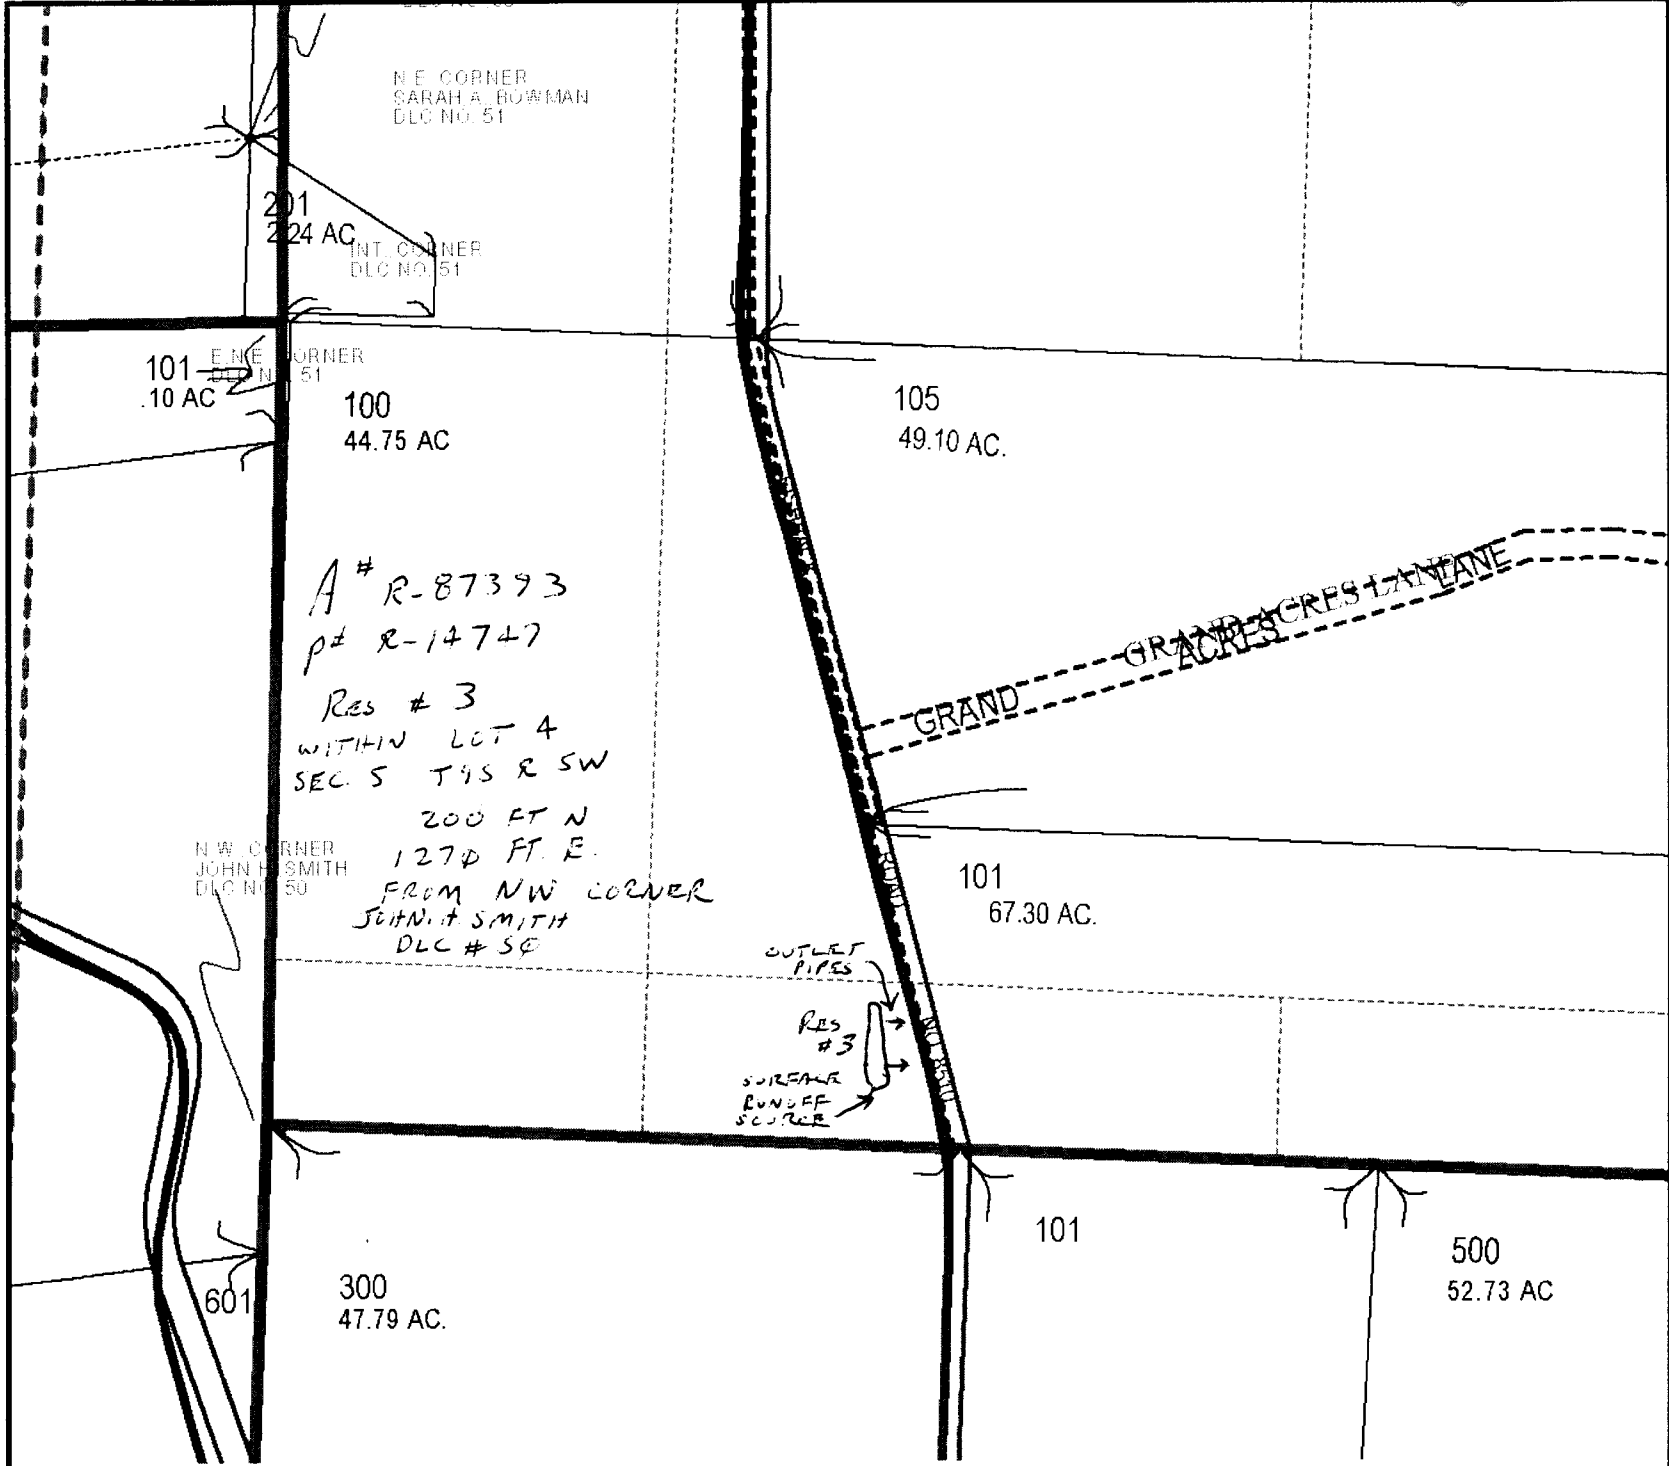

RECEIVED
 JUN 24 2014
 WATER RESOURCES DEPT
 SALEM, OREGON

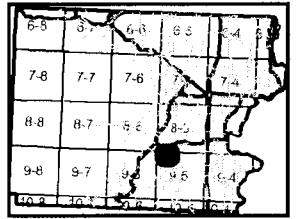

This map was produced using the Polk County GIS data. The GIS data is maintained by the county to support its governmental activities. The county is not responsible for map errors, omissions, misuse or misinterpretation.

1 in. = 400 ft.

6/16/2014

POLK COUNTY