


Claim of Beneficial Use

In The Name of
MARY BARTELS

T26S-R4W-S17A
Tax Lot: 300

Application: S-86283
Permit: S-54324

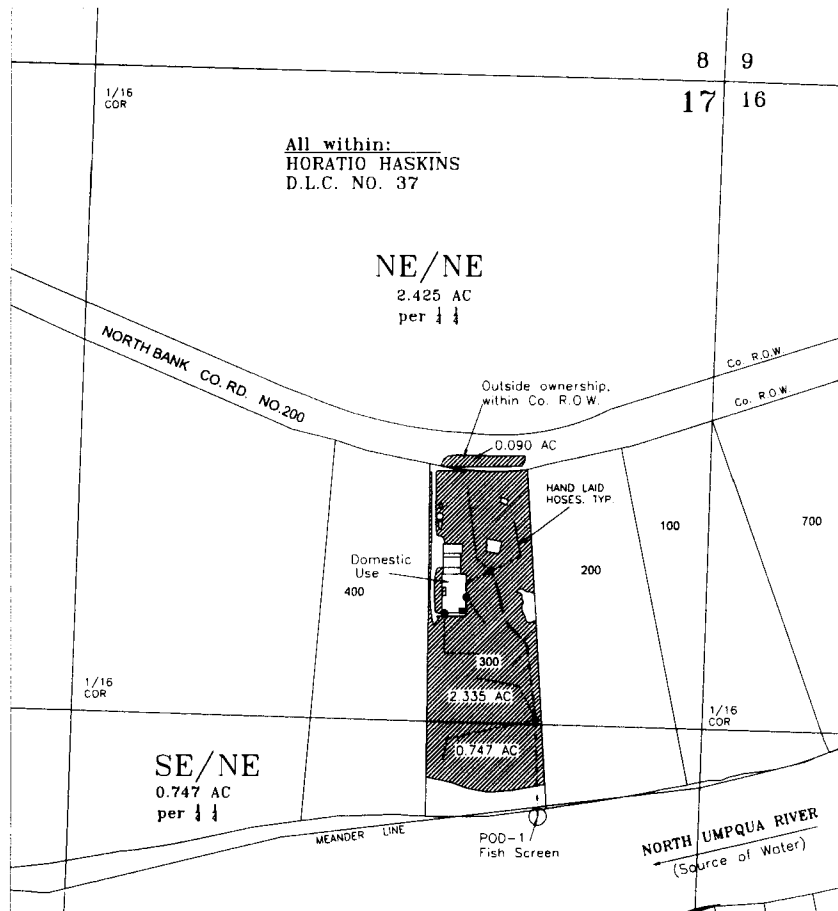


PURPOSE OR USE:

Domestic: Whole House Use, Two Outside Spigots.
Irrigation: Total Acres= 3.172 AC
Within D.L.C. 37= 3.172 AC
NE/NE= 2.425 AC
SE/NE= 0.747 AC

- = POD-1 & Fish Screen
- = Spigot (4 total) [four irrigation, two domestic]
- - - = 1-1/2" PVC Main Line
- = Whole House Water Treatment System

POD-1 & Fish Screen: More or less 1,532 feet South and 382 feet West from the NE corner of Section 17, common with 16, 9 & 8. South of the current Meander Line outside of DLC. 37, Horatio Haskins.

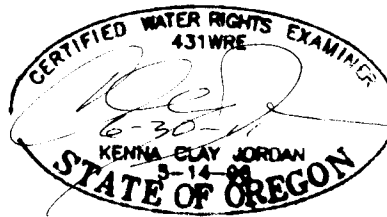

1 INCH = 400 FEET

This map is not intended to provide legal dimensions and/or locations of property ownership lines.

Locations per 1/4 1/4 are derived by assumed fit of aerial photo orientation to ground surveys and/or tax assessor maps.

JORDAN ENGINEERING
460 JORDAN LANE
ROSEBURG, OREGON 97471
(541) 673-1931

08-19-10