



Township 4 North, Range 25 East, W.M.
SW 1/4 SW 1/4 of Section 14
MORROW COUNTY

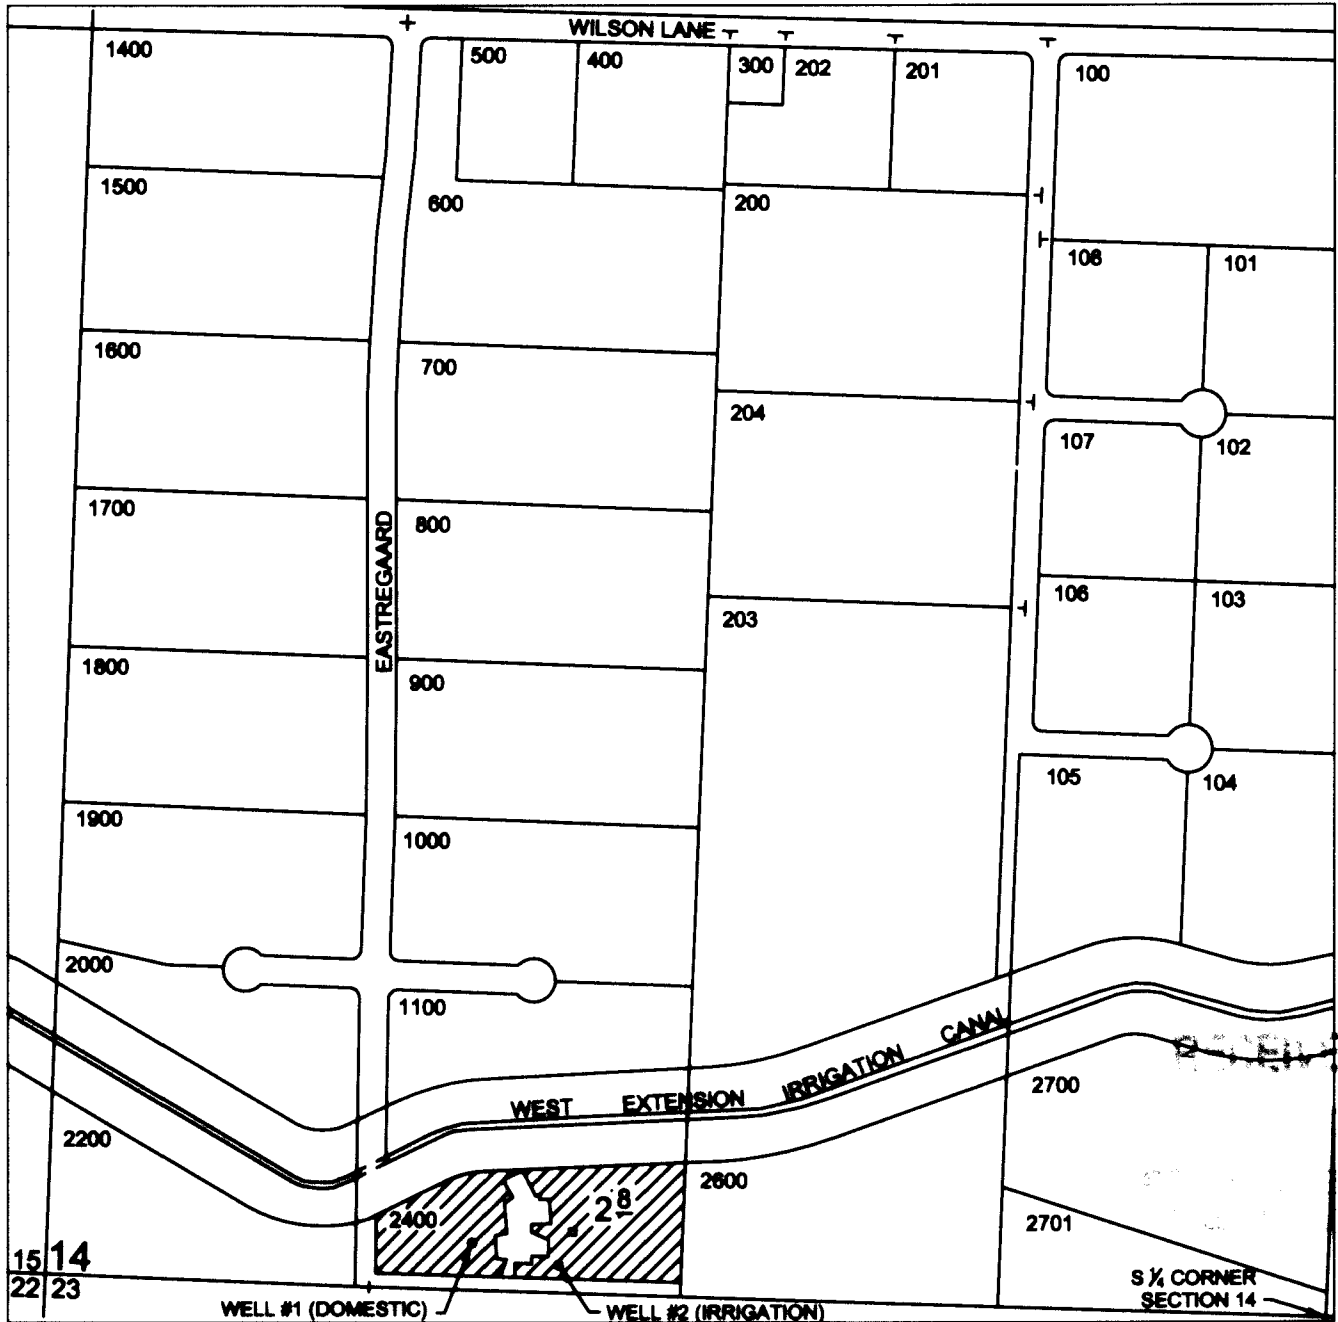

WELL #2 (IRRIGATION) LOCATED 80 FEET NORTH & 1080 FEET EAST FROM THE SW CORNER OF SECTION 14
 WELL #1 (DOMESTIC) LOCATED 100 FEET NORTH & 880 FEET EAST FROM THE SW CORNER OF SECTION 14



FINAL PROOF SURVEY
 under
 Appl. G16162, Per. G-15698
 in the names of
Ron and Sharon Mailloux
 June 2nd, 2010

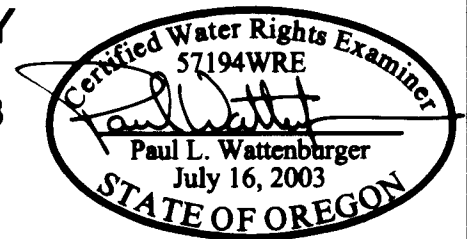

THIS MAP WAS PREPARED FOR THE PURPOSE OF IDENTIFYING THE LOCATION OF A WATER RIGHT ONLY AND IS NOT INTENDED TO PROVIDE LEGAL DIMENSIONS OR LOCATION OF PROPERTY OWNERSHIP LINES.

EXPIRES: 6/30/12