


CLAIM OF BENEFICIAL USE

APPLICATION S-86271

PERMIT S-54258

IN THE NAME OF DAVE & LINDA RUSSEL

SECTIONS 14 & 23, TOWNSHIP 26 SOUTH RANGE 6 WEST, W.M.
DOUGLAS COUNTY OREGON

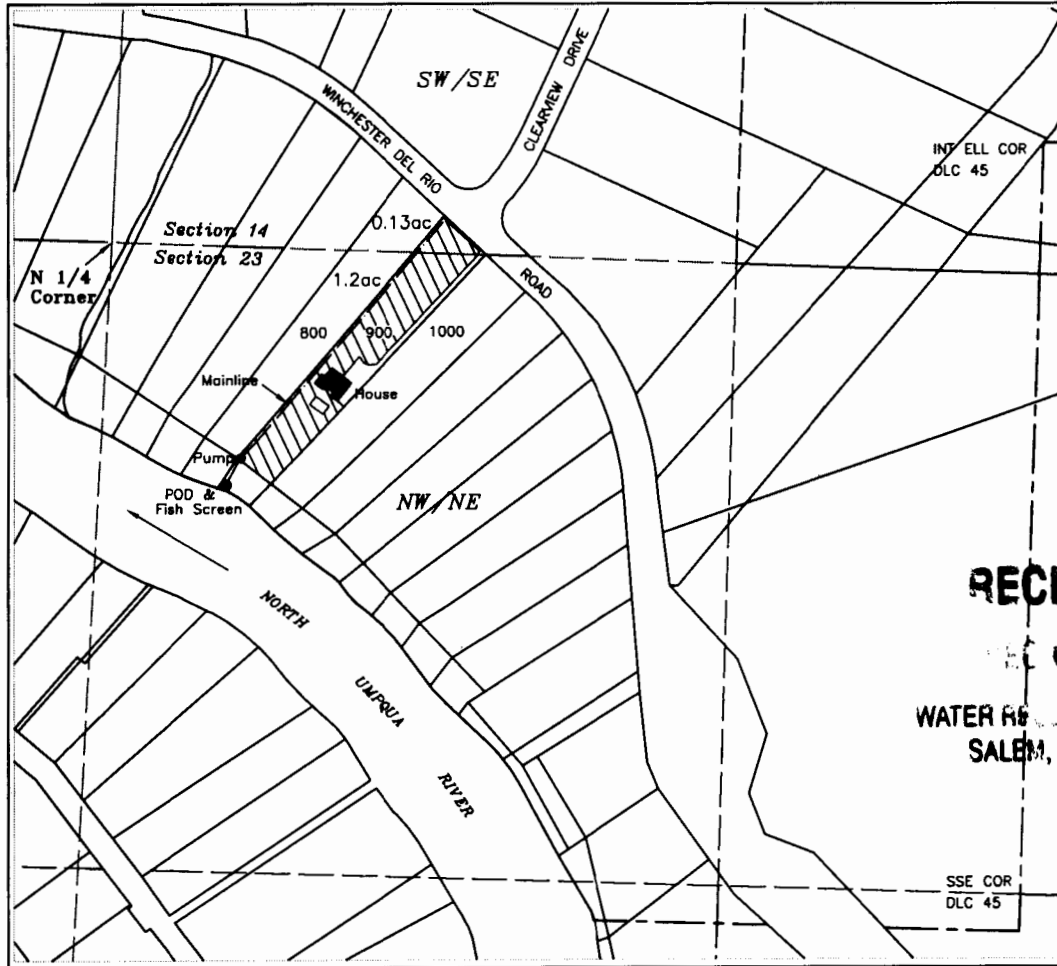


RECEIVED

DEC 09 2009


WATER RESOURCES DEPT
SALEM, OREGON

POD - DLC 45, NW/NE, Section 23; 500 feet south & 265 feet east from the north 1/4 corner Section 23

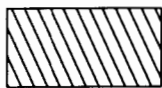

Irrigated area 1.33 acres


Scale
1 inch = 400 feet

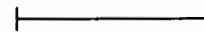

Locations per 1/4 1/4 are derived by assumed fit of aerial photo orientation to ground surveys and/or tax assessor maps

For purpose of locating POD Cardinal directions are in reference from point of beginning (N 1/4 COR Section 23) extending along its boundary lines

This map is not intended to provide legal dimensions or locations of property ownership lines

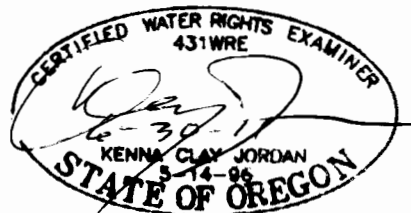

JORDAN ENGINEERING
460 JORDAN LANE
ROSEBURG, OR 97471
(541) 673-1931

10/8/2009 n.e.d.