


T.4S. R.1E. Section 4, W.M.

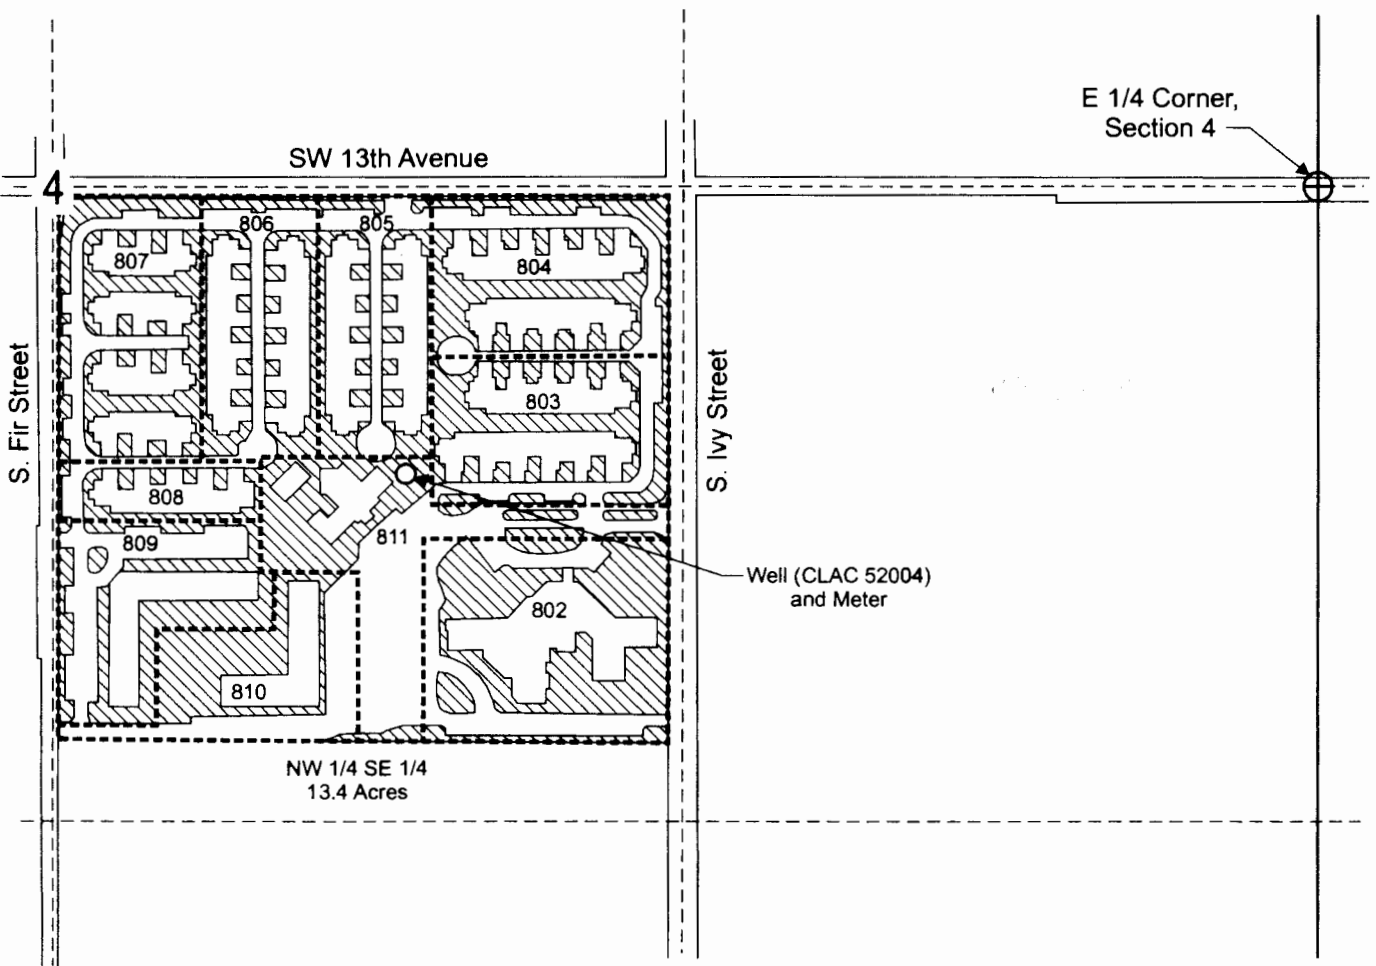


Well (CLAC 52004) is located 600 feet south and 1,900 feet west from the E 1/4 corner, Section 4.

 Area (13.4 Acres) irrigated under Application G-13862, Permit G-12335.


----- Tax lot boundary

807 Parcel number on Tax Map 4 1E 4D

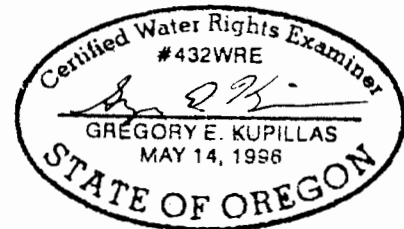

EXPIRATION DATE: 6/30/2011

Scale: 1" = 400'

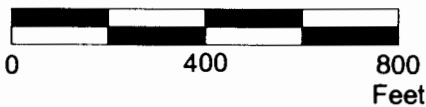

This map was prepared for the purpose of identifying the location of a water right only and is not intended to provide legal dimensions or location of property ownership lines.



Claim of Beneficial Use Map
Application G-13862, Permit G-12335


Hope Village
T.4S. R.1E. Section 4, W.M.

Pacific Hydro-Geology Inc.

2/2010

T.4S. R.1E. Section 4, W.M.


SW 13th Avenue

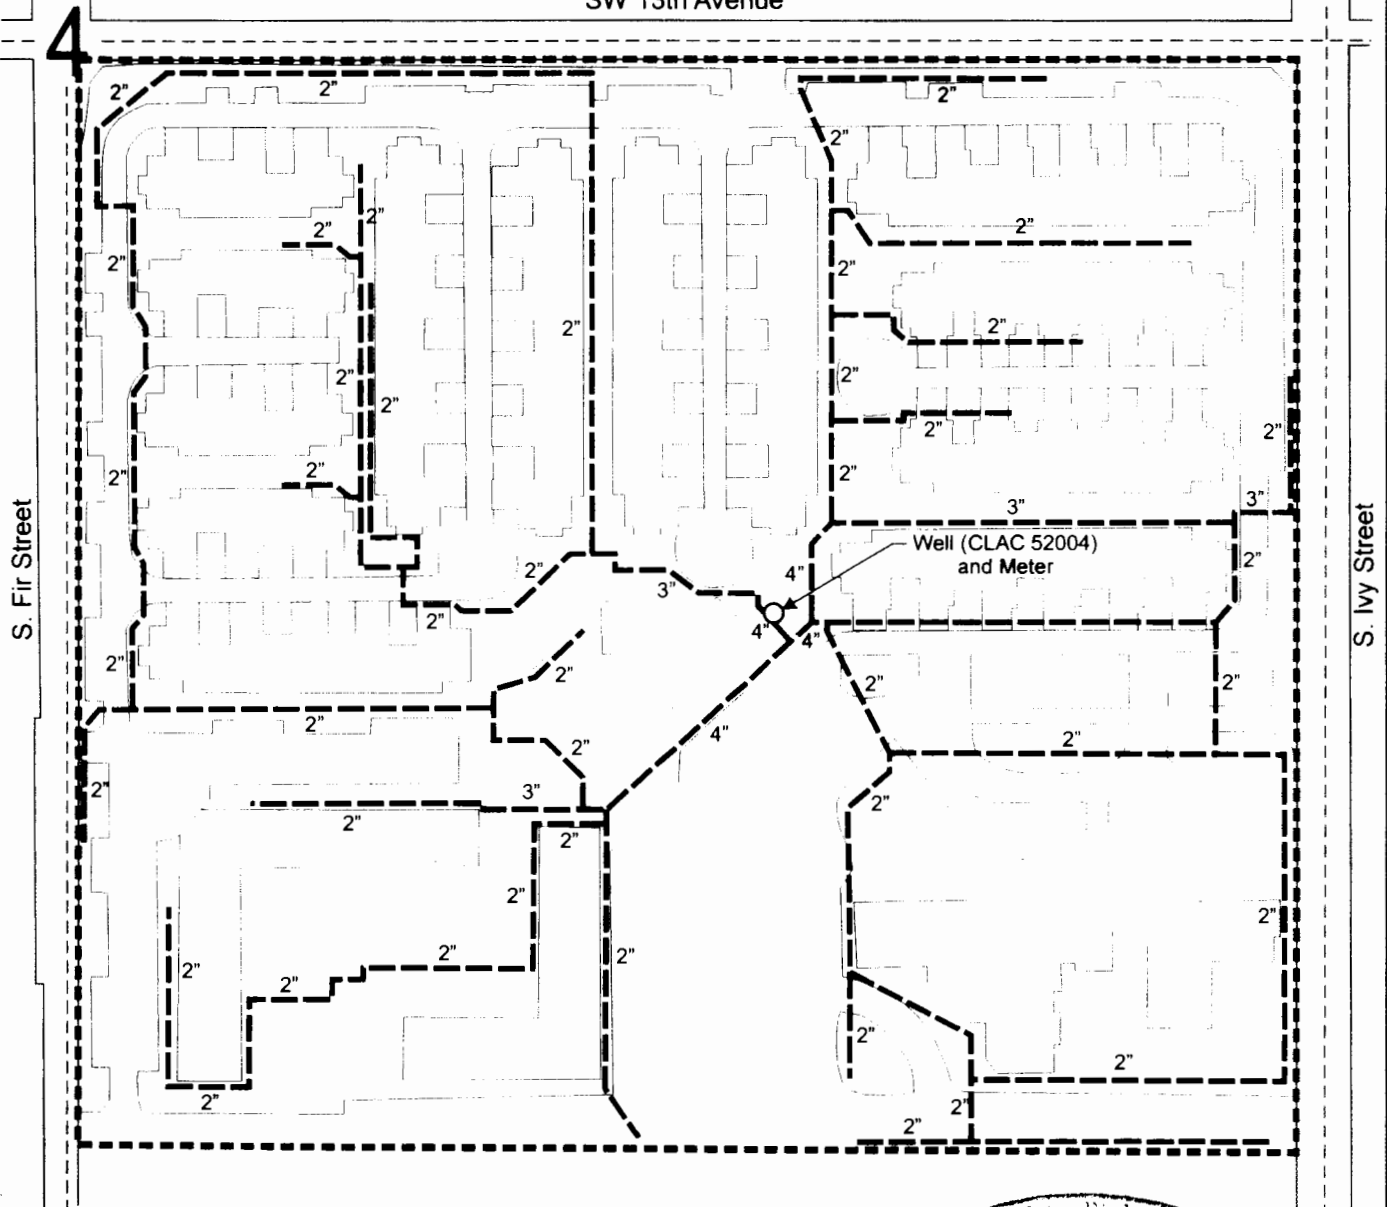

Well (CLAC 52004) is located 600 feet south and 1,900 feet west from the E-1/4 corner, Section 4


--- Property boundary

—4" Irrigation Mainline

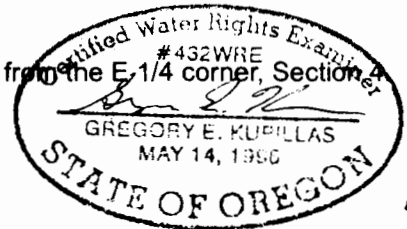

EXPIRATION DATE: 6/30/2011

Scale: 1" = 200'

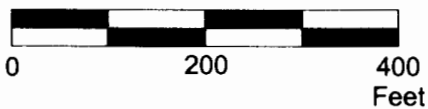

This map was prepared for the purpose of identifying the location of a water right only and is not intended to provide legal dimensions or location of property ownership lines.

Map Showing Locations of Irrigation Main Lines
Claim of Beneficial Use for
Application G-13862, Permit G-12335

Pacific Hydro-Geology Inc.

Hope Village

2/2010

T.4S. R.1E. Section 4, W.M.