


CLAIM OF BENEFICIAL USE  
 FOR: NORMA ANN STULTS  
 BY: DUANE W. KIRBY  
 T26S, R6W, SE¼ SEC WM  
 FISH SCREEN IS LOCATED AT THE POD  
 PERMIT NO S-54282  
 SCALE 1" = 500'

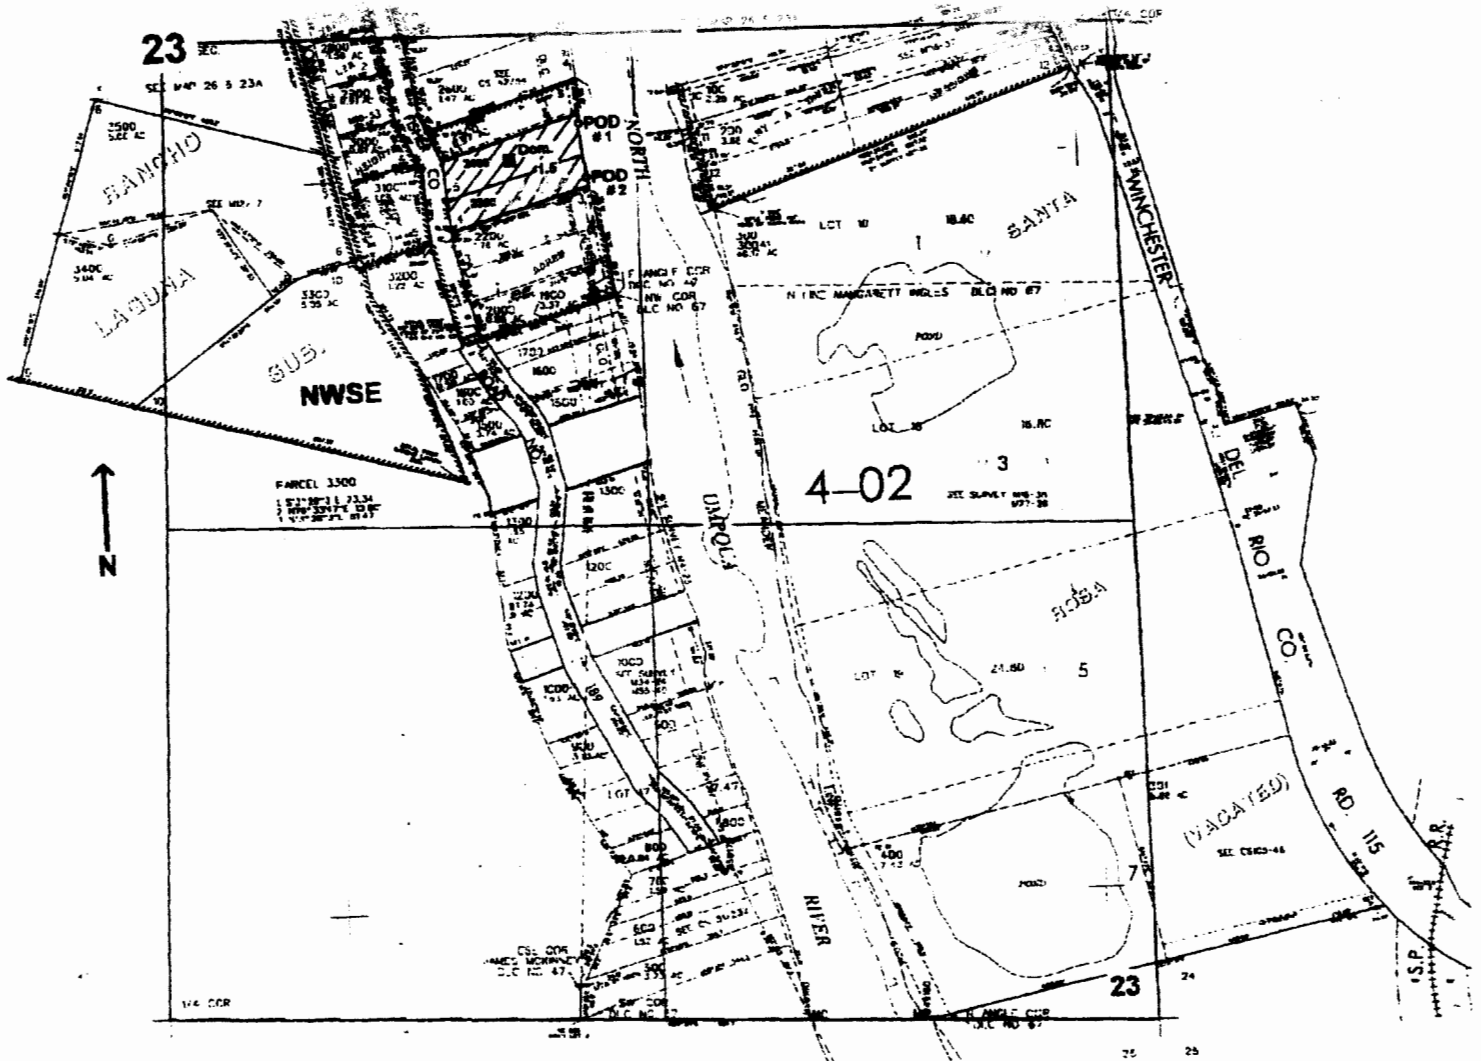

POD # 1 - 250 ft. S. and 1130 ft. E }  
 from the center of Sec. 23  
 POD # 2 - 400 ft. S. and 1150 ft. E }

THE PURPOSE OF THIS MAP IS TO IDENTIFY THE LOCATION OF THE WATER RIGHT. IT IS NOT INTENDED TO PROVIDE INFORMATION RELATIVE TO THE LOCATION OF PROPERTY OWNERSHIP BOUNDARY LINES.

