


Lands irrigated from well under Permit number 15258.



Existing Mainline

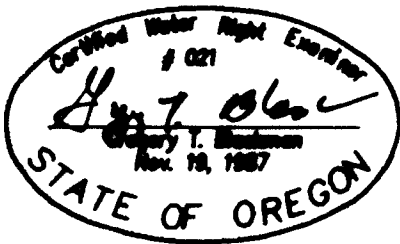

February 23, 2007

**FINAL PROOF MAP OF  
WATER RIGHTS FROM  
A NEW WELL**

**FOR  
GRACE TORKELSON**

BY  
BAGETT - GRIFFITH & BLACKMAN  
2008 ADAMS AVENUE  
LAGRANDE, OREGON 97850

Application No. G- 15473

Permit Number G- 15258

NOTE: The preparation of this map was for the purpose of identifying the location of the proposed water right and has no intent to provide dimensions or location of property ownership lines. Location information shown hereon was furnished by the applicant.

**RECEIVED**  
MAR 08 2007  
WATER RESOURCES DEPT  
SALEM OREGON