



MAP TO ACCOMPANY WATER
RIGHT TRANSFER APPLICATION
FOR
ERNEST & DIXIE SHUFFIELD

SECTION 24, TOWNSHIP 29 SOUTH,
RANGE 17 EAST, W.M.
LAKE COUNTY, OREGON

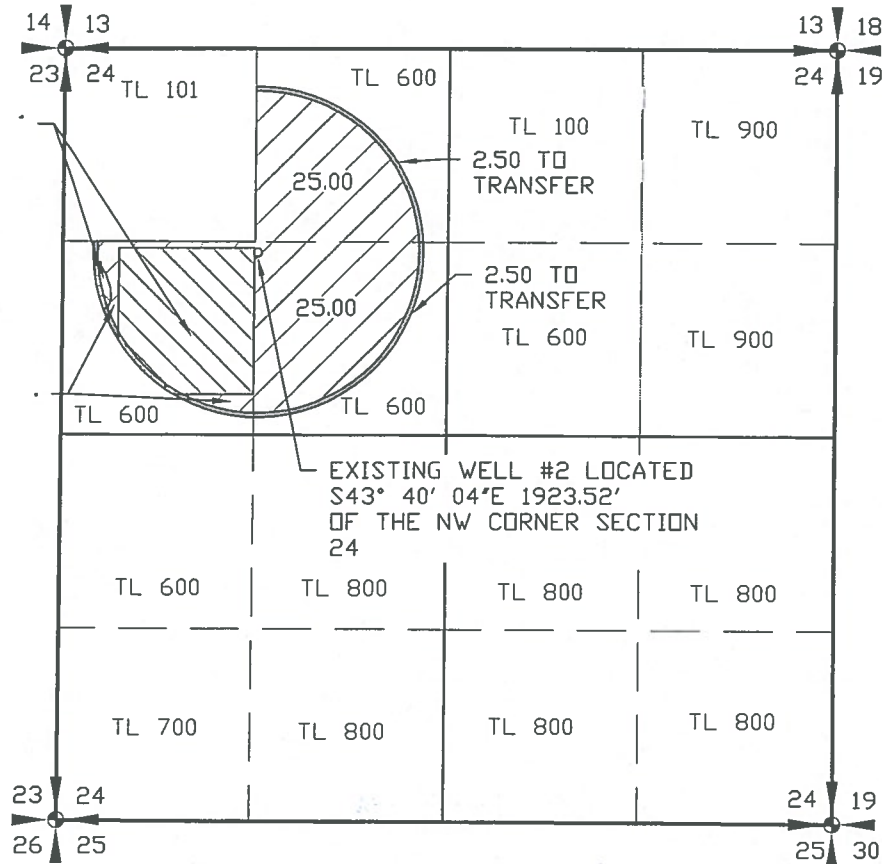

EXISTING


- PLACE OF USE CERTIFICATE 87790
TO REMAIN - 46.98 ACRES
- PLACE OF USE CERTIFICATE 87464
TO REMAIN 20.52 ACRES
- PROPOSED TRANSFER FROM
CERTIFICATE 87790 - 5.44 ACRES
- PROPOSED TRANSFER FROM
CERTIFICATE 87464 - 0.45 ACRES

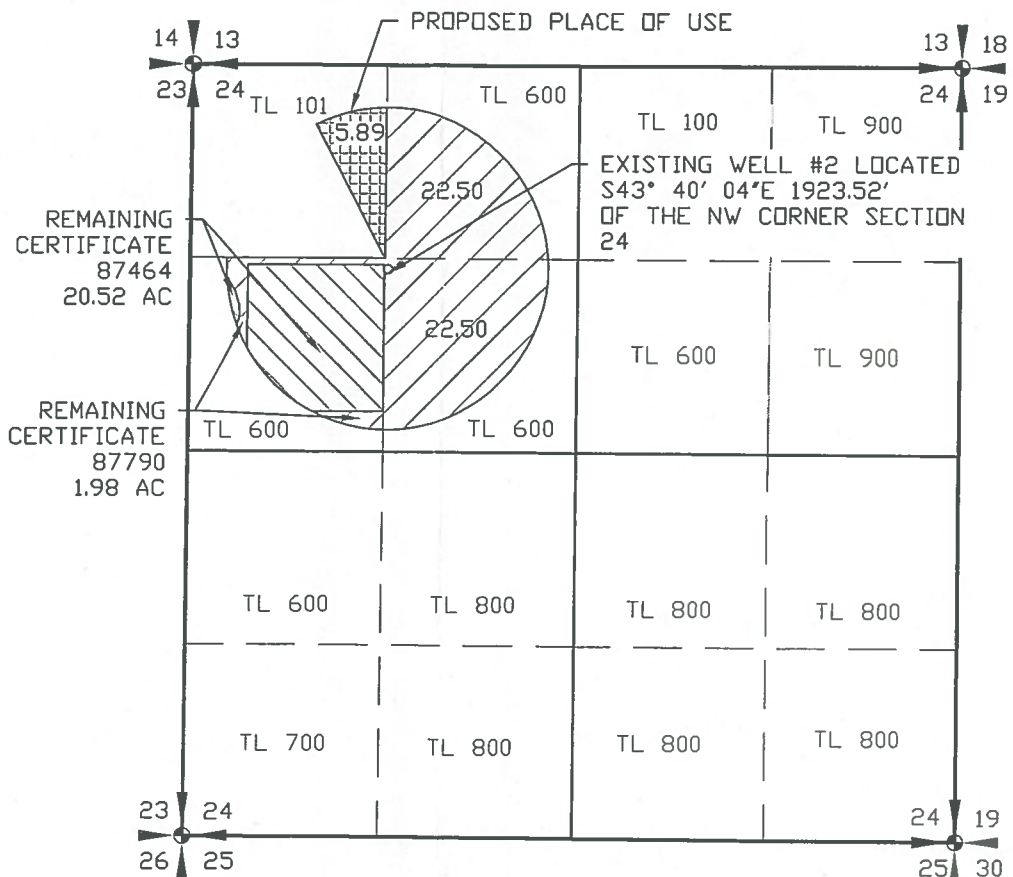

PROPOSED

- PLACE OF USE CERTIFICATE 87790
TO REMAIN - 46.98 ACRES
- PLACE OF USE CERTIFICATE 87464
TO REMAIN 20.52 ACRES
- PROPOSED TRANSFER FROM
CERTIFICATE 87790 - 5.44 ACRES
- PROPOSED TRANSFER FROM
CERTIFICATE 87464 - 0.45 ACRES
- PROPOSED PLACE OF USE
5.89 ACRES

RECEIVED BY OWRD
JUN 24 2015
SALEM, OR

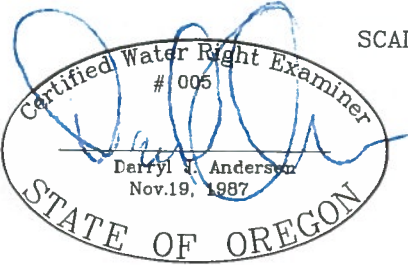

RENEWAL 12/31/15

- LEGEND
- SECTION LINE
 - 1/4 SECTION LINE
 - 1/16 SECTION LINE
 - TAXLOT LINE

TRANSFER NO. 12089

NOTE:
PREPARATION OF THIS MAP IS FOR IDENTIFYING PROPOSED
WATER RIGHTS ONLY. IT HAS NO INTENT TO PROVIDE
LOCATIONS OR DIMENSIONS OF PROPERTY BOUNDARIES.

REVISION	BY

ANDERSON ENGINEERING
AND SURVEYING, INC.
P.O. BOX 28
LAKEVIEW, OREGON 97630
(541) 947-4407
FAX: 947-2321

FOR:
CHAYLON SHUFFIELD
P.O. BOX 85
SUMMER LAKE, OR 97640

MAP TO ACCOMPANY WATER
RIGHT TRANSFER APPLICATION


DATE:	05/18/15
SCALE:	1" = 1320'
DWG. BY:	R.C.
JOB:	2015-053
FILE:	2015-053
SHEET:	1

CLAIM OF BENEFICIAL USE MAP
NW 1/4 Section 24, T.29S. R.17E., W.M.
Lake County, Oregon

Application G-14315
Permit G-13246



SCALE
1" = 1320'

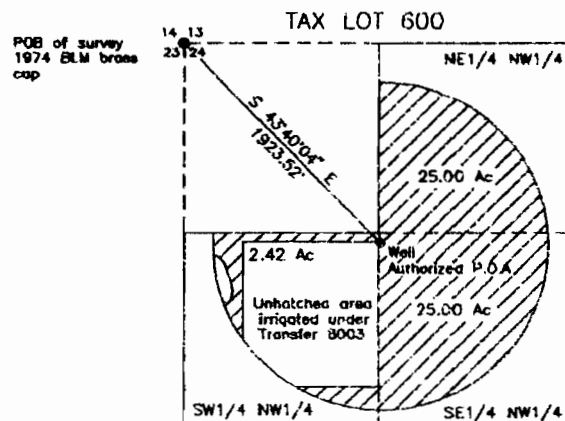

52.42 Acres irrigated
Permit G-13246

Prepared for: Ernest D. & Dixie Shuffield
Prepared by: Sundet & Associates
P.O. Box 1228
Lakeview, OR 97630

March 2004 DR #17204

This map is for the purpose of identifying the location
of the water right only and is not intended to provide
legal dimensions or location of property ownership lines.

