


COBU MAP # 0524

RECEIVED

AUG 1 2 2010

WATER RESOURCES DEPT
SALEM, OREGON

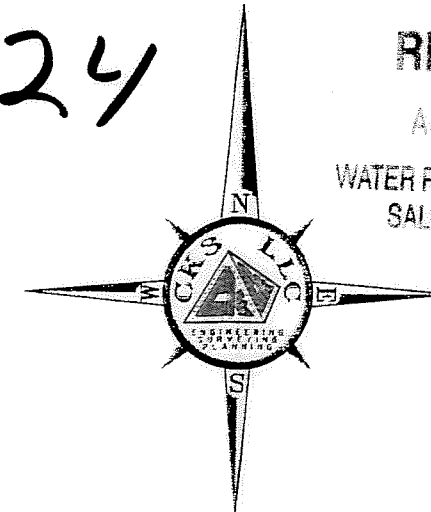

1320' 0 1320' 2640'

SCALE 1" = 1320'


ALL DISTANCES SHOWN HERE ARE IN FEET UNLESS NOTED OTHERWISE

LEGEND

DISCRIPTION	SYMBOLS
SECTION LINE	—
QUARTER-QUARTER	----
HIGH WATER LINE	----
SECTION CORNER	9 10 16 15
RECOGNIZED SURVEY CORNER	⊙
EXISTING DAM	▨
MEASURING DEVICE	⊙


APPLICATION NO. R-69471

PERMIT NO. R-12081

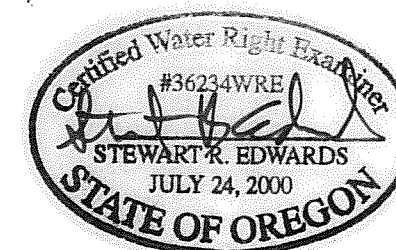

DISCLAIMER

I, STEWART R. EDWARDS, HEREBY CERTIFY: THAT THIS MAP WAS MADE TO BE PART OF THE CLAIM OF BENEFICIAL USE FOR A RESERVOIR PERMIT. SECTIONAL LINES SHOWN ARE APPROXIMATE AND THIS MAP IS NOT INTENDED FOR ANY OTHER USE AND DOES NOT GUARANTEE LAND OWNERSHIP.

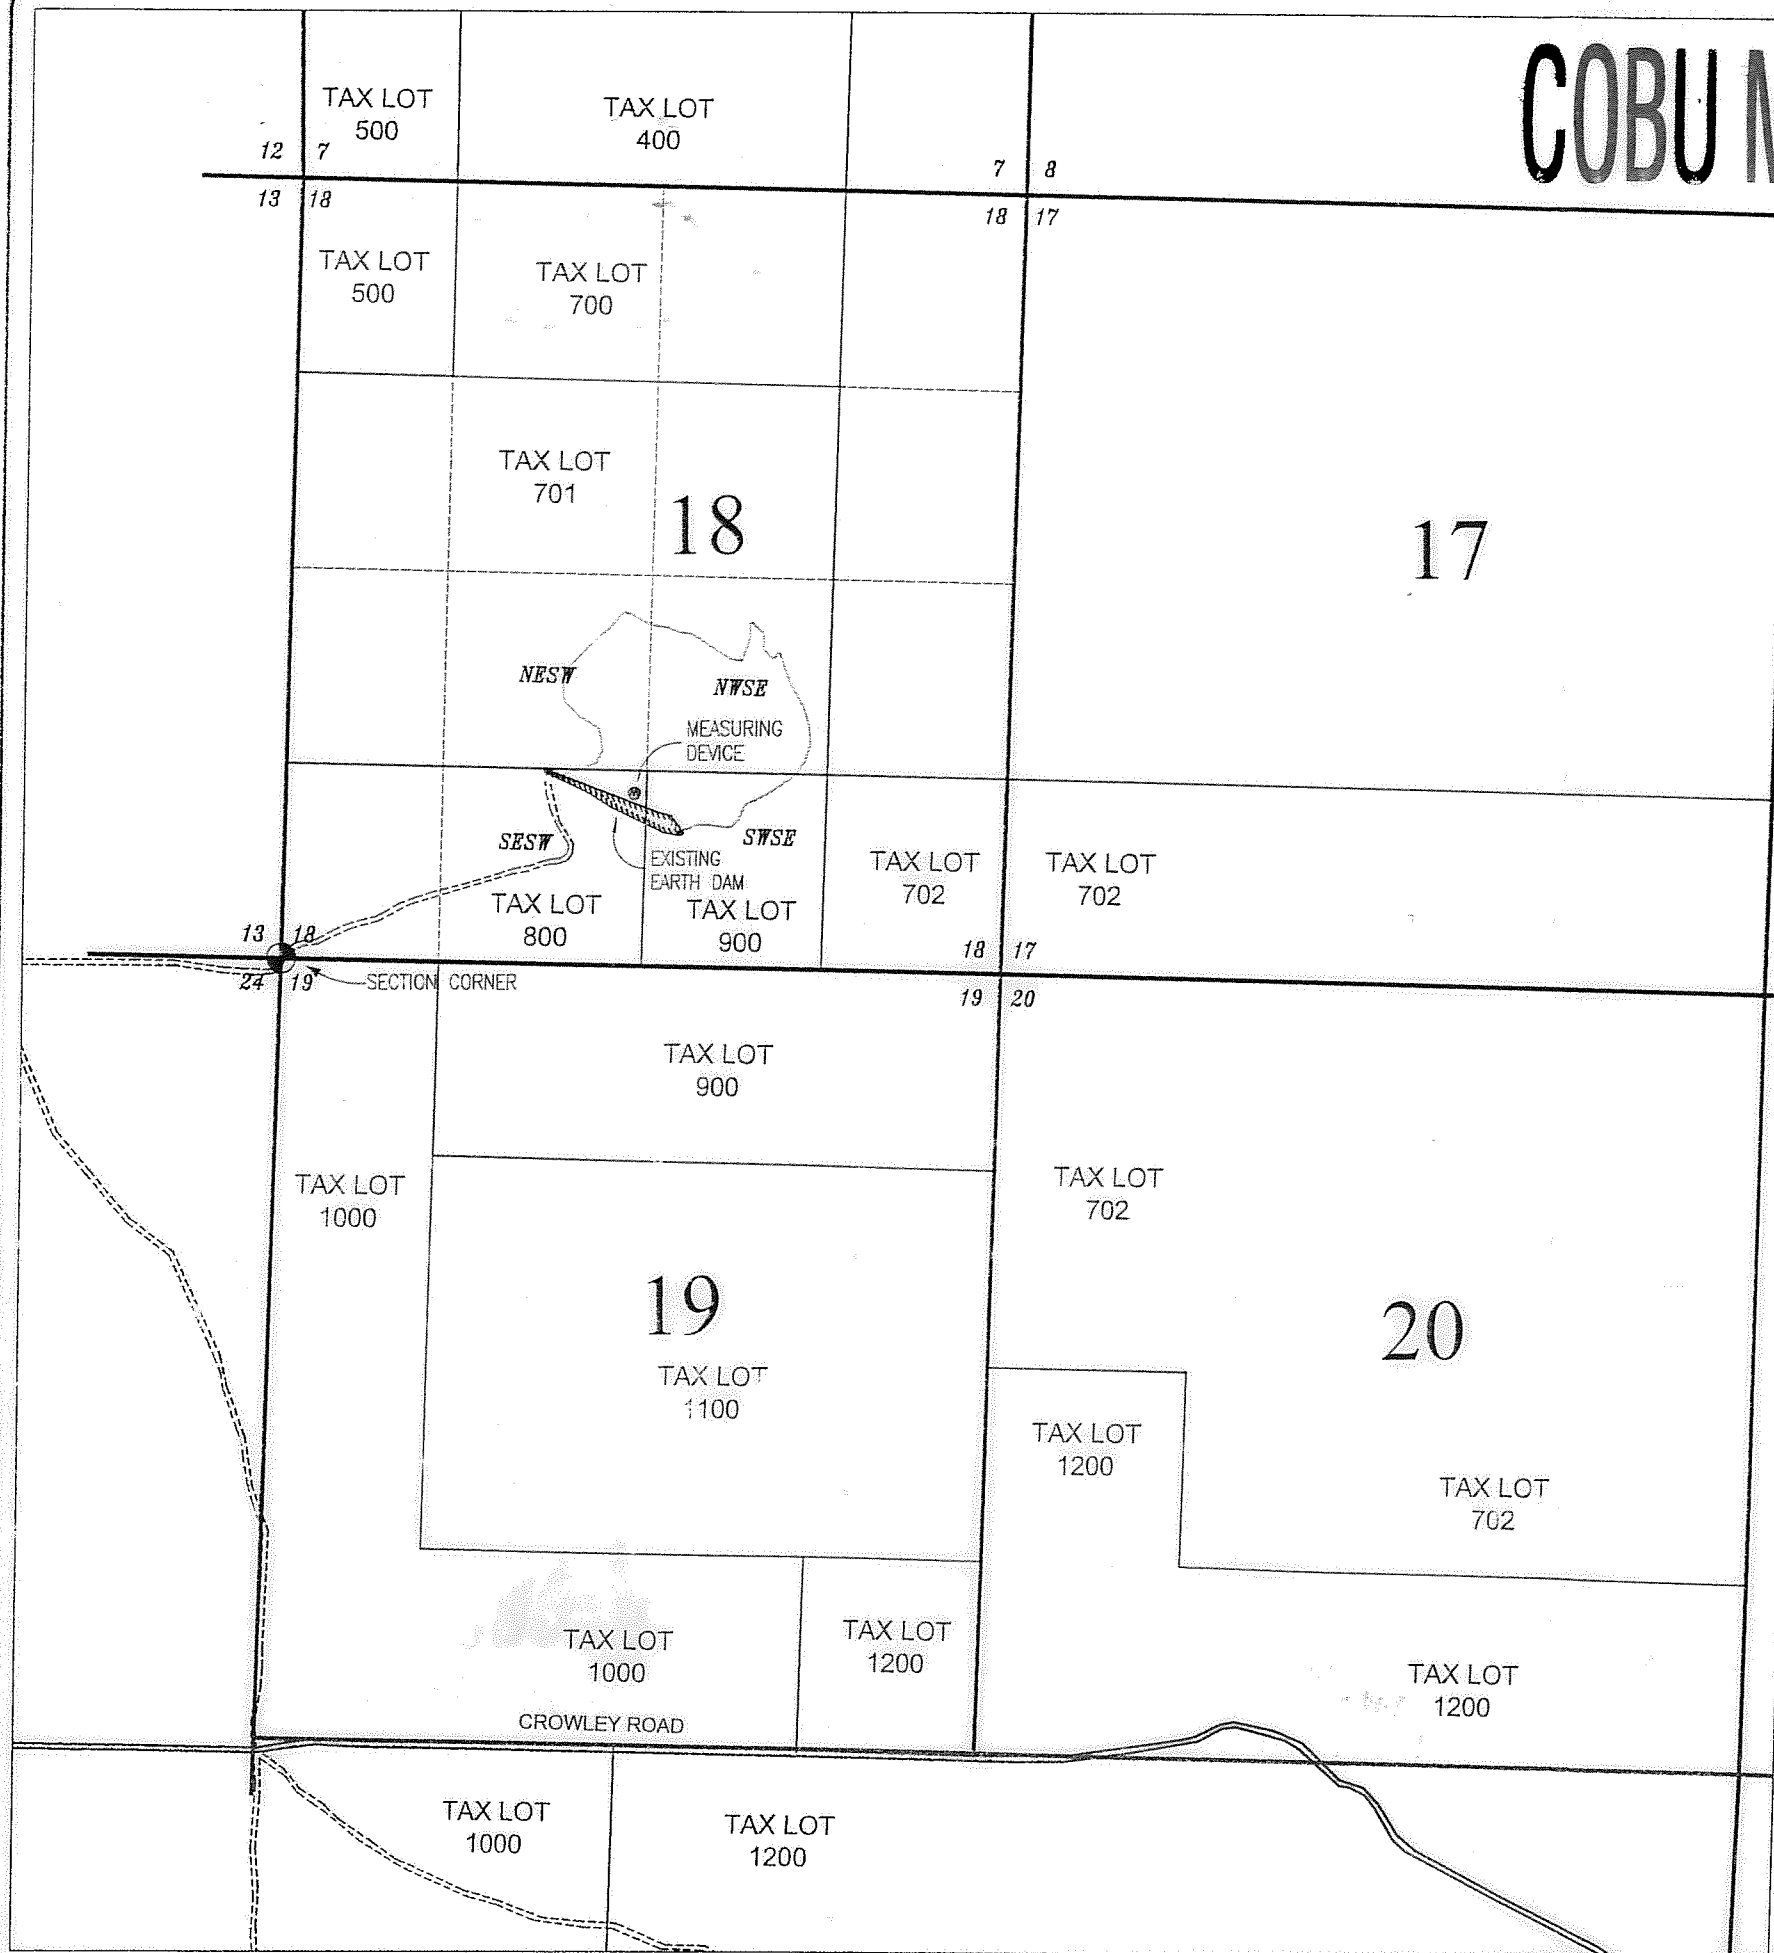

ENG. BY:	APR. BY:	DWG. BY:	DATE:
	STU EDWARDS	PW	August 9, 2010

#	REVISION	DATE
1		
2		
3		
4		

COBU MAP T 26S, R 40E, SEC. 18, W.M. MALHEUR COUNTY, OREGON	Kirsti Katarina Sulphin 1401 Alameda Drive ONTARIO, OREGON 97144
--	--

CK3, LLC 308 S.W. 5th Avenue Ontario, Oregon 97144 Phn: (541) 889-5411 Fax: (541) 889-2074	CIVIL-STRUCTURAL-ELECTRICAL ENGINEERING, SURVEYING & PLANNING
--	--

WT	SHEET: 1 OF 1	JOB: WO-08003
----	---------------	---------------

0524