
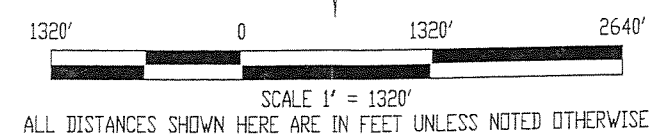
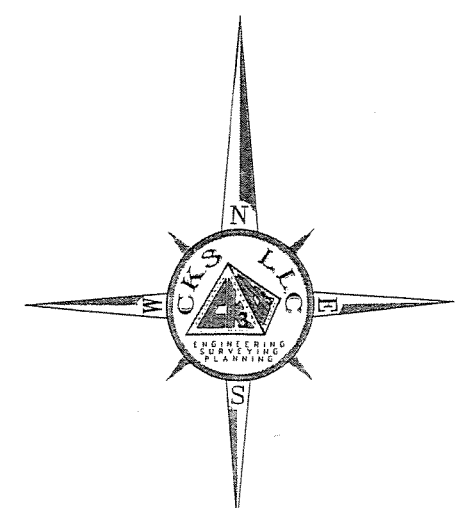



2504-111

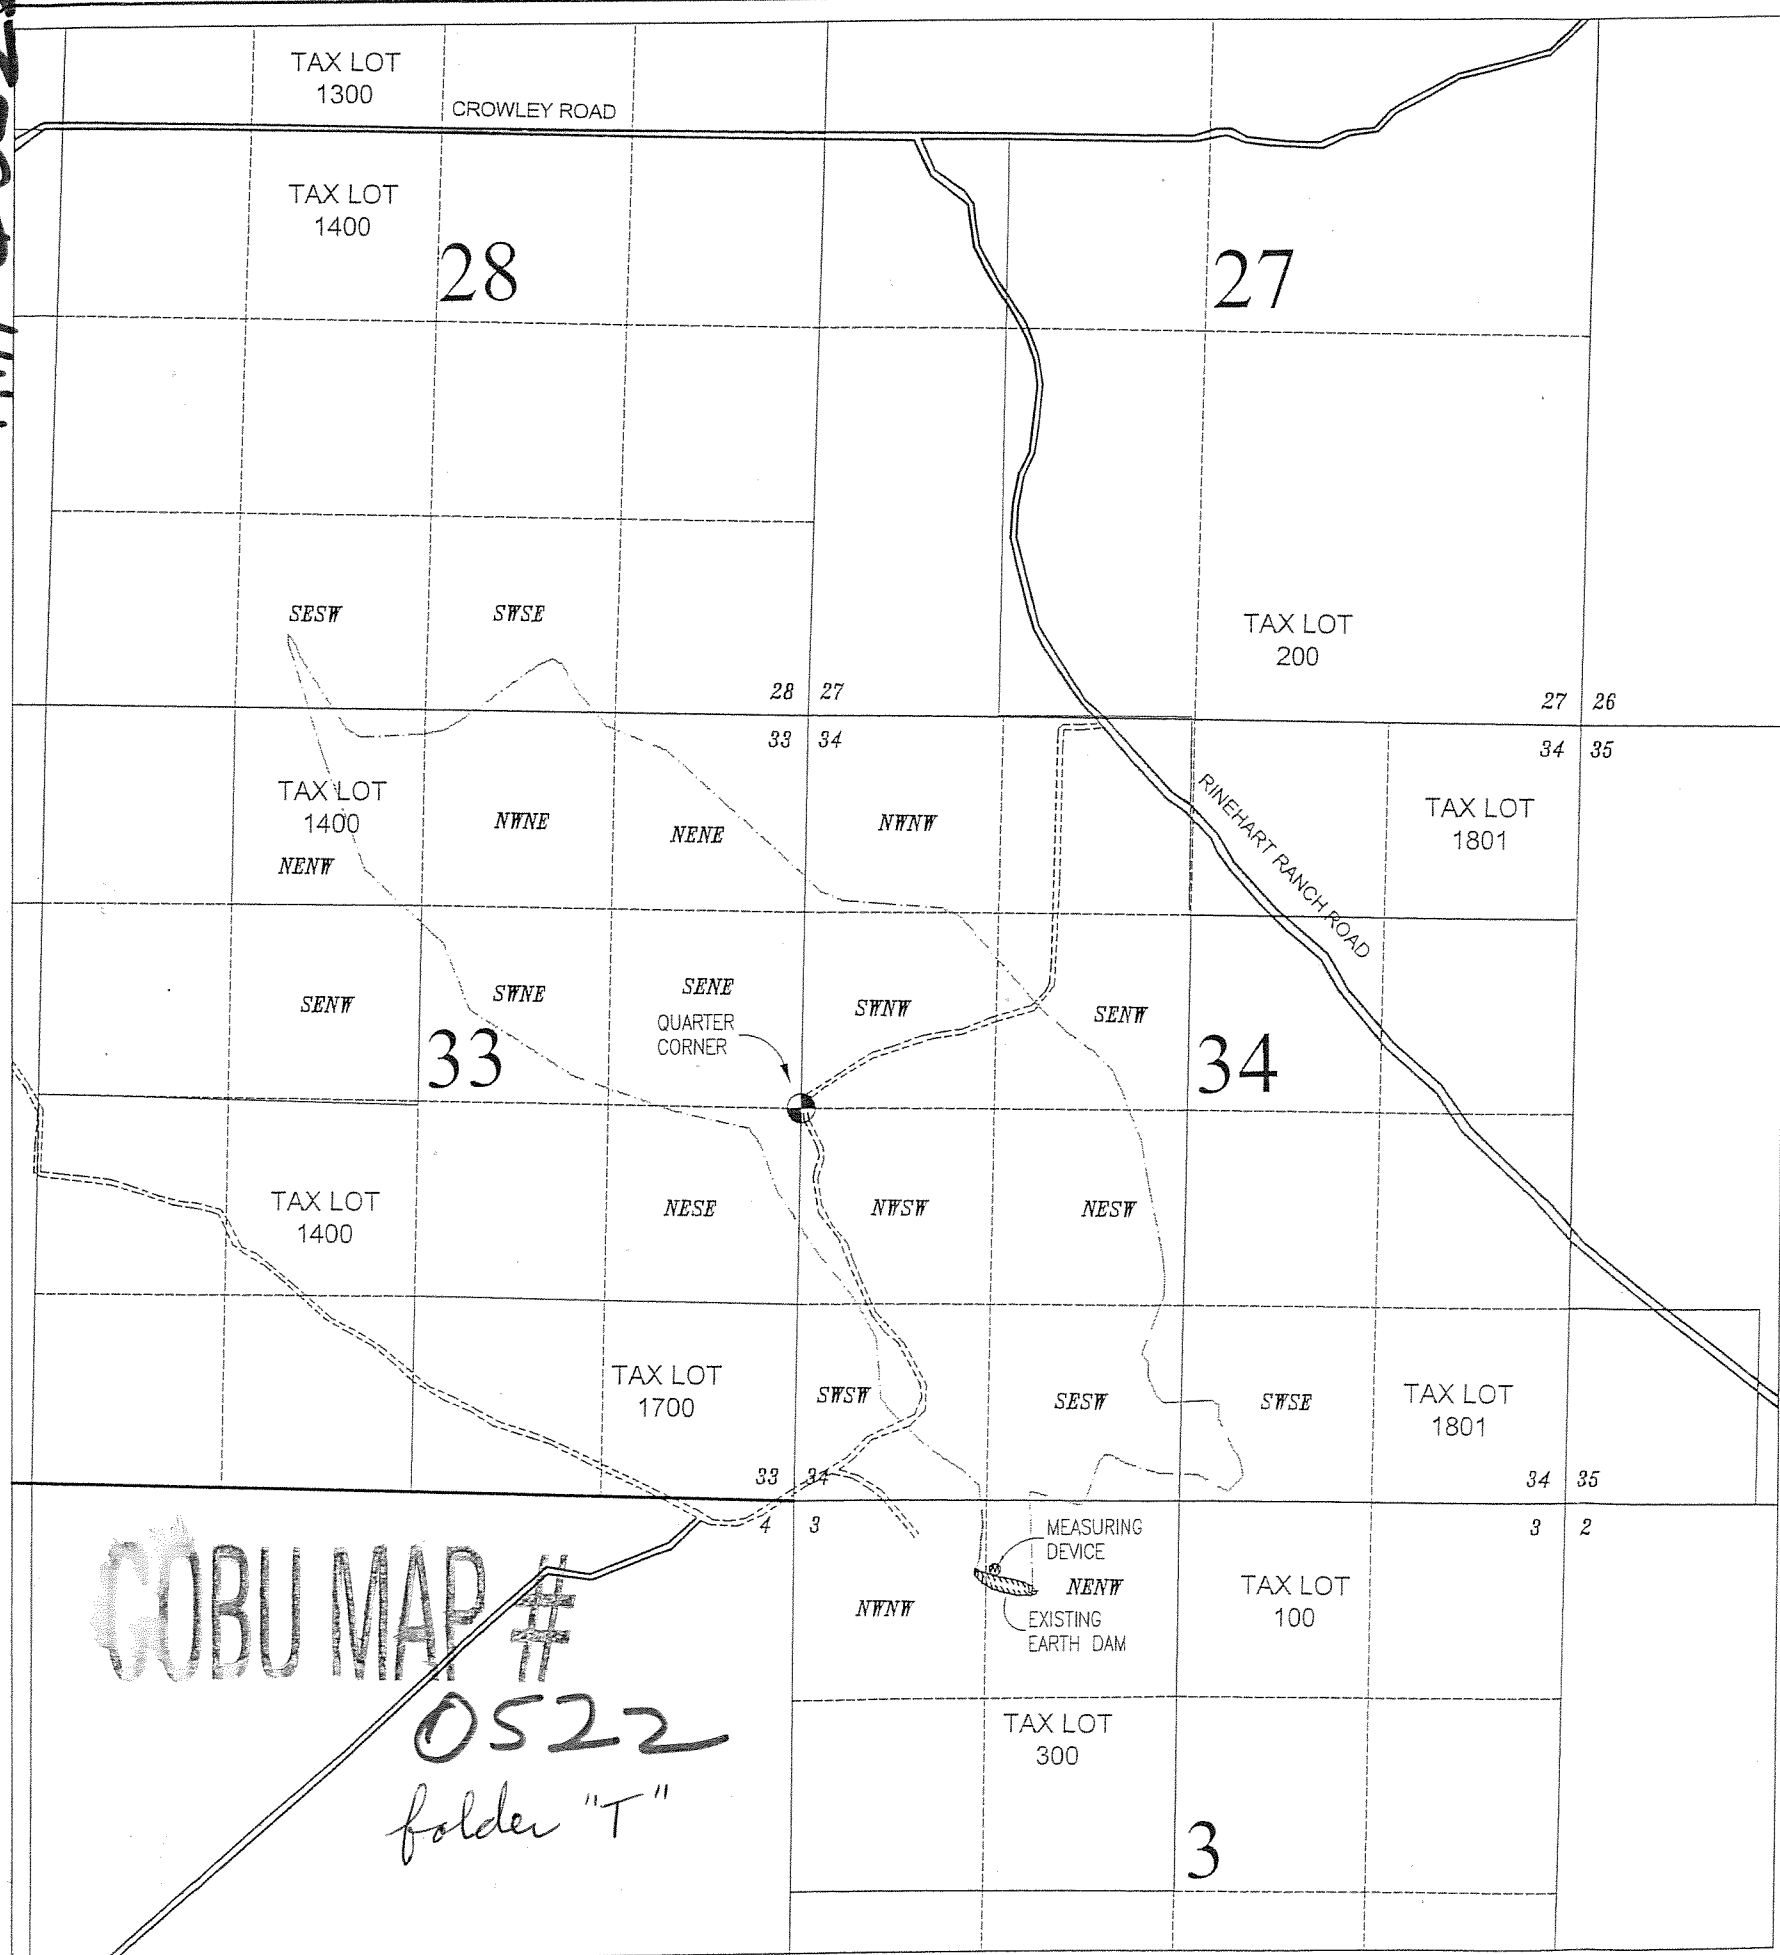

LEGEND	
DISCRIPTION	SYMBOLS
SECTION LINE	—
QUARTER-QUARTER	- - - -
HIGH WATER LINE	9 10
SECTION CORNER	16 15
RECOGNIZED SURVEY CORNER	+
EXISTING DAM	▨
MEASURING DEVICE	Ⓜ

APPLICATION NO. R-69472
PERMIT NO. R-12080

RECEIVED
AUG 05 2010
STEWART R. EDWARDS
SHEET 1 OF 1

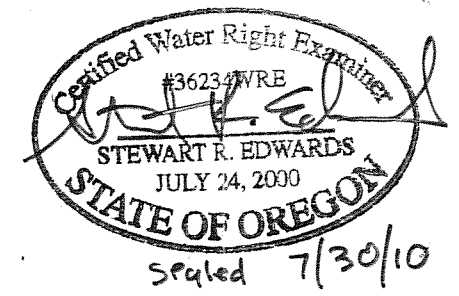

DISCLAIMER
I, STEWART R. EDWARDS, HEREBY CERTIFY: THAT THIS MAP WAS MADE TO BE PART OF THE CLAIM OF BENEFICIAL USE FOR A RESERVOIR PERMIT. SECTIONAL LINES SHOWN ARE APPROXIMATE AND THIS MAP IS NOT INTENDED FOR ANY OTHER USE AND DOES NOT GUARANTEE LAND OWNERSHIP.

THIS DRAWING, & ALL INFORMATION HEREIN, REMAIN THE PROPERTY OF CKS, L.L.C. ALL RIGHTS ARE EXPRESSLY RESERVED & IT MAY NOT BE REPRODUCED IN WHOLE OR IN PART WITHOUT THE EXPRESSED WRITTEN CONSENT OF CKS, L.L.C.

ENG. BY: _____
APR. BY: STU EDWARDS
DWG. BY: PW
DATE: July 30, 2010

#	REVISION	DATE
1		
2		
3		
4		

C.O.B.U. MAP for HOPE RESERVOIR
T 27S, R 40E,
SEC. 3, WM.
MALHEUR COUNTY, OREGON
Steve Russell
PO BOX 780
HARPER, OREGON 97906

CKS, L.L.C.
368 S.W. 5th Avenue
Ontario, Oregon 97914
Phn: (541) 889-5411
Fax: (541) 889-2074
**CIVIL-STRUCTURAL-ELECTRICAL
ENGINEERING, SURVEYING & PLANNING**

W T
SHEET: 1 OF 1
JOB: WO-08001