


COBU Map
Ronald Decker
T35S, R2W, Sec. 12
Permit G-15701

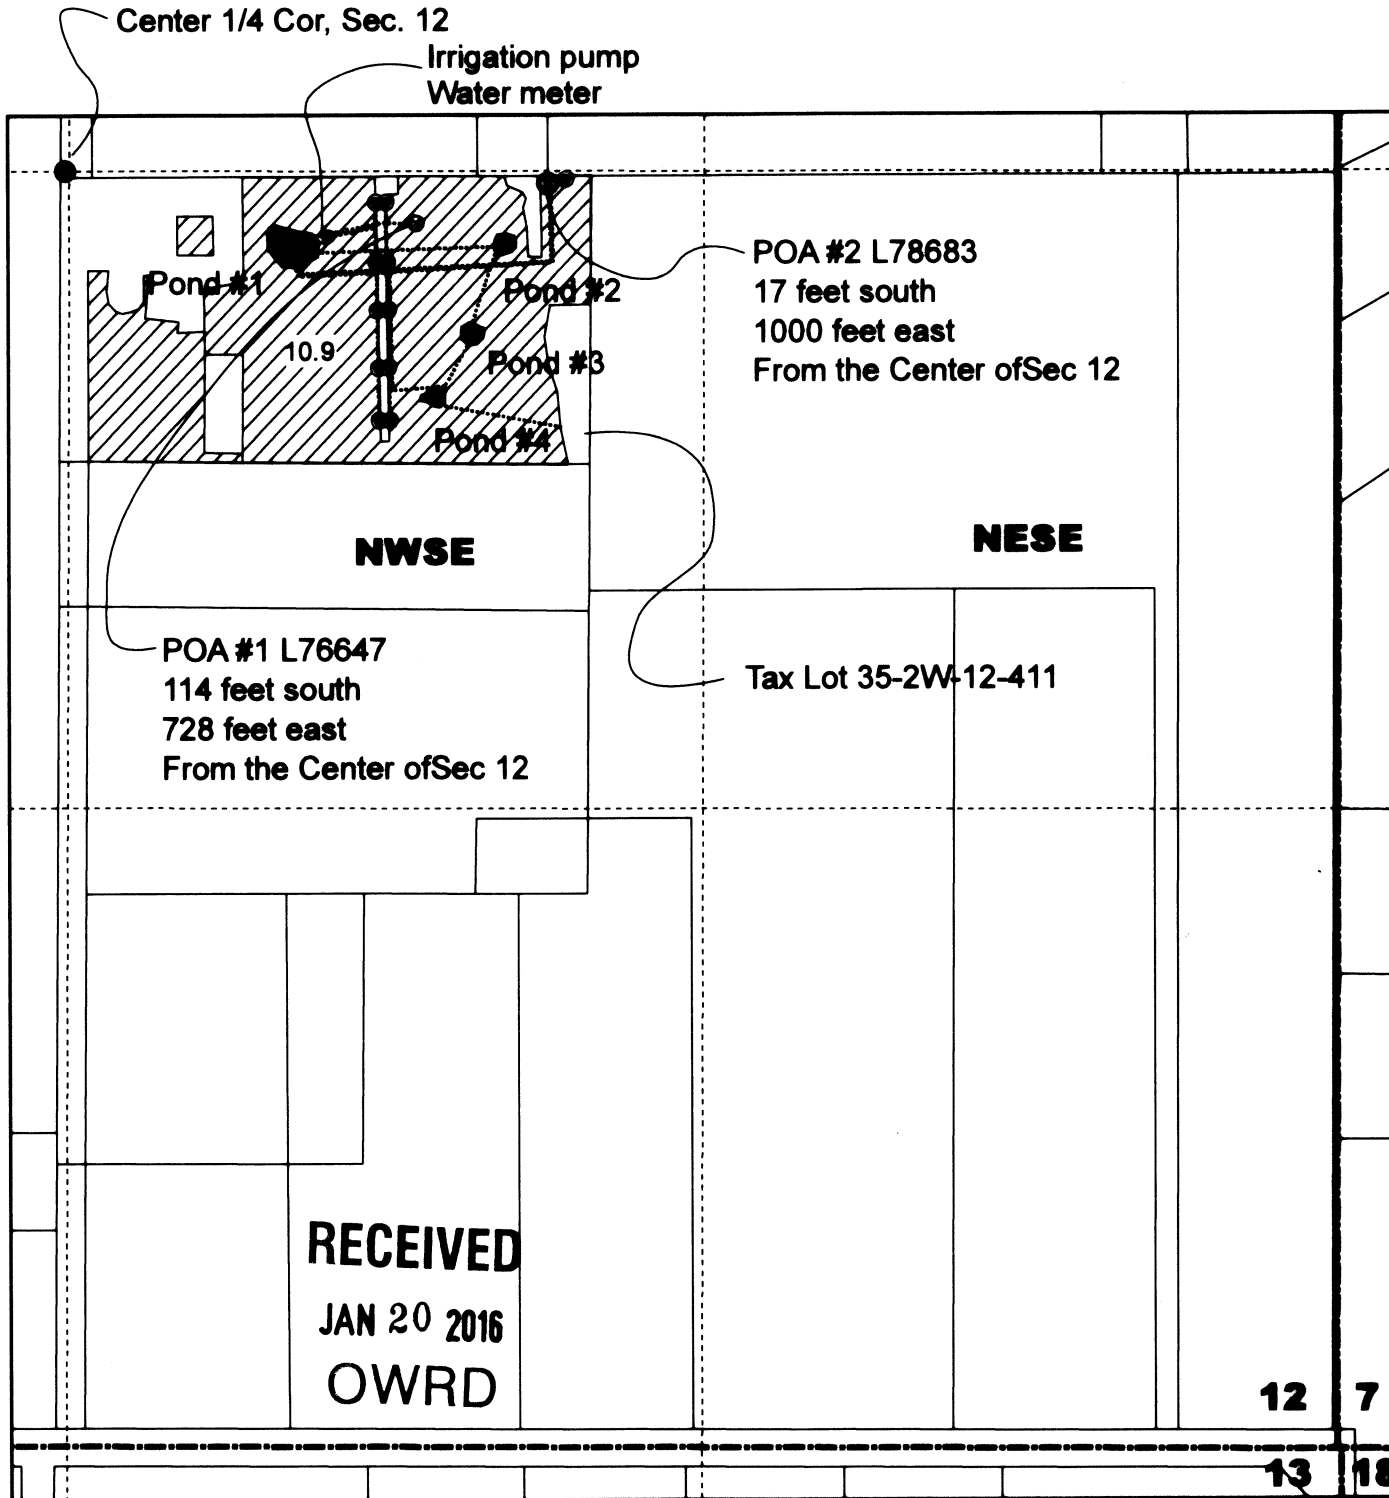

Legend

- Pipelines Decker
- Irrigated area
- ⊗ Well
- Decker ponds
- Irrigation riser




Feet
0 200 400

1 inch = 400 feet



RENEWS: 12/31/2017

Note: This map is not intended to provide legal dimensions or locations of property ownership lines.

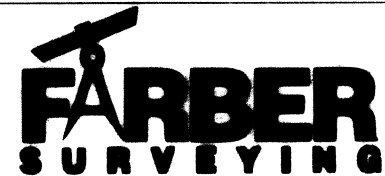

PO Box 5286
 Central Point, Oregon 97502
 Phone 541-664-5599
 Fax 541-664-5603
 Email hfarber@charter.net

Farber & Sons, Inc.
 431 Oak Street
 Central Point, Oregon
 Tax ID: 93-1057173