
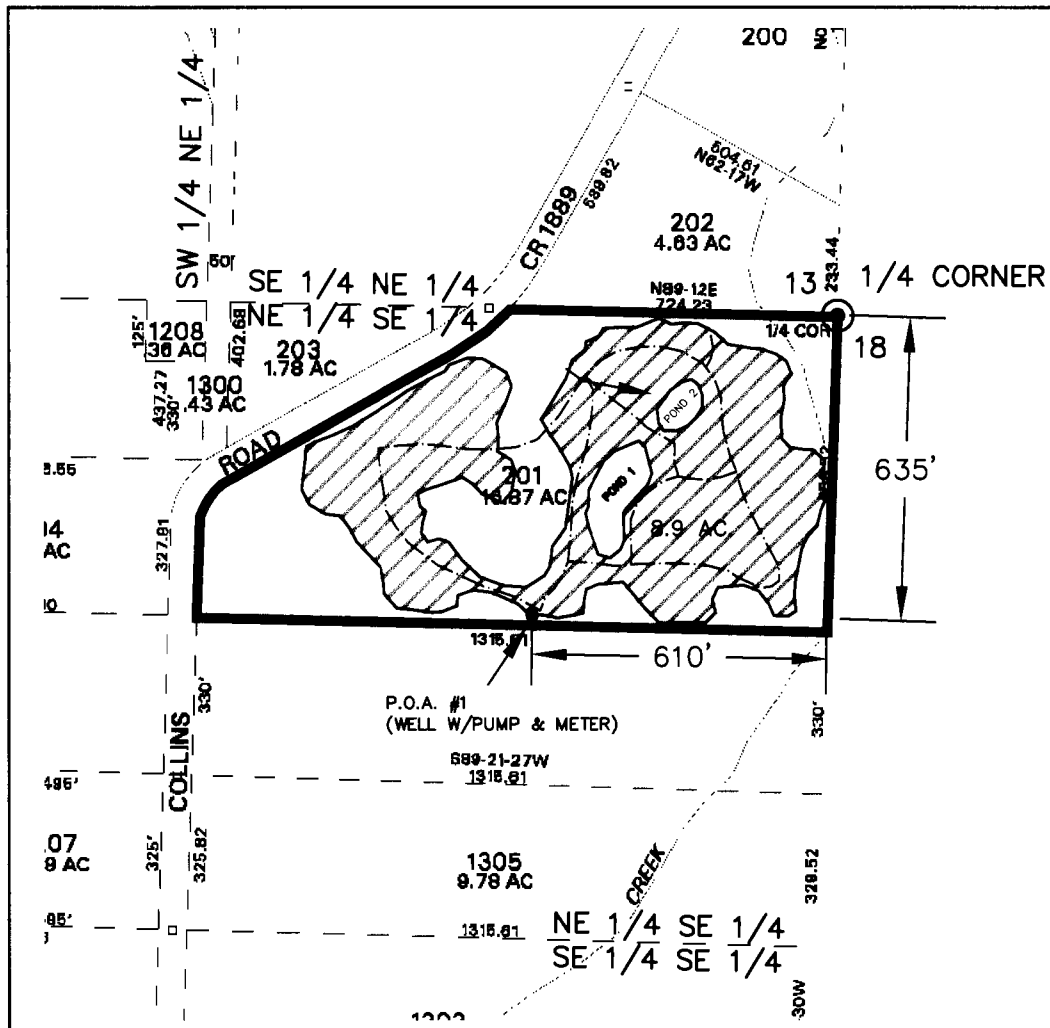


CLAIM OF BENEFICIAL USE MAP FOR BAMBOO GARDENS

LOCATED IN THE NE 1/4 OF THE SE 1/4 OF SECTION 13. TOWNSHIP 2 NORTH,
RANGE 3 WEST, WILLAMETTE MERIDIAN.
WASHINGTON COUNTY, OREGON

APPLICATION #G-15779

PERMIT#G-15362

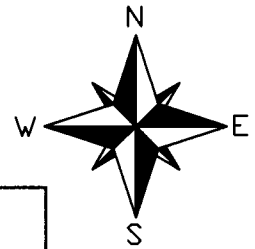

GOVERNMENT CORNER


POINT OF APPROPRIATION #1 IS LOCATED 635'
SOUTH AND 610' WEST OF THE 1/4 CORNER
COMMON TO SECTIONS 13 & 18.



IRRIGATION AREAS — PERMIT
S-53843 & G-15362

EXISTING MAIN IRRIGATION PIPE LINES

THIS MAP WAS PREPARED FOR THE PURPOSE OF
IDENTIFYING THE LOCATION OF A WATER RIGHT ONLY AND
IS NOT INTENDED TO PROVIDE LEGAL DIMENSIONS OR
LOCATION OF PROPERTY OWNERSHIP LINES.

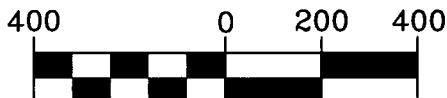

1 inch = 400 ft.

PREPARED FOR:

NED JAQUITH
18900 NW COLLINS RD.
NORTH PLAINS, OR 97133

RECEIVED

DEC 28 2010

WATER RESOURCES DEPT

MAP BASE:
WASHINGTON COUNTY TAX MAP
SECTION 13, T2N, R3W



EXPIRES 6/30/2011

Stuntzner



PROJECT: 310-2-047 PH.203
DRAWING: 3102047B.dwg
DRAWN BY: JMH
CHECKED BY: TMH
DATE: 8-3-2010