
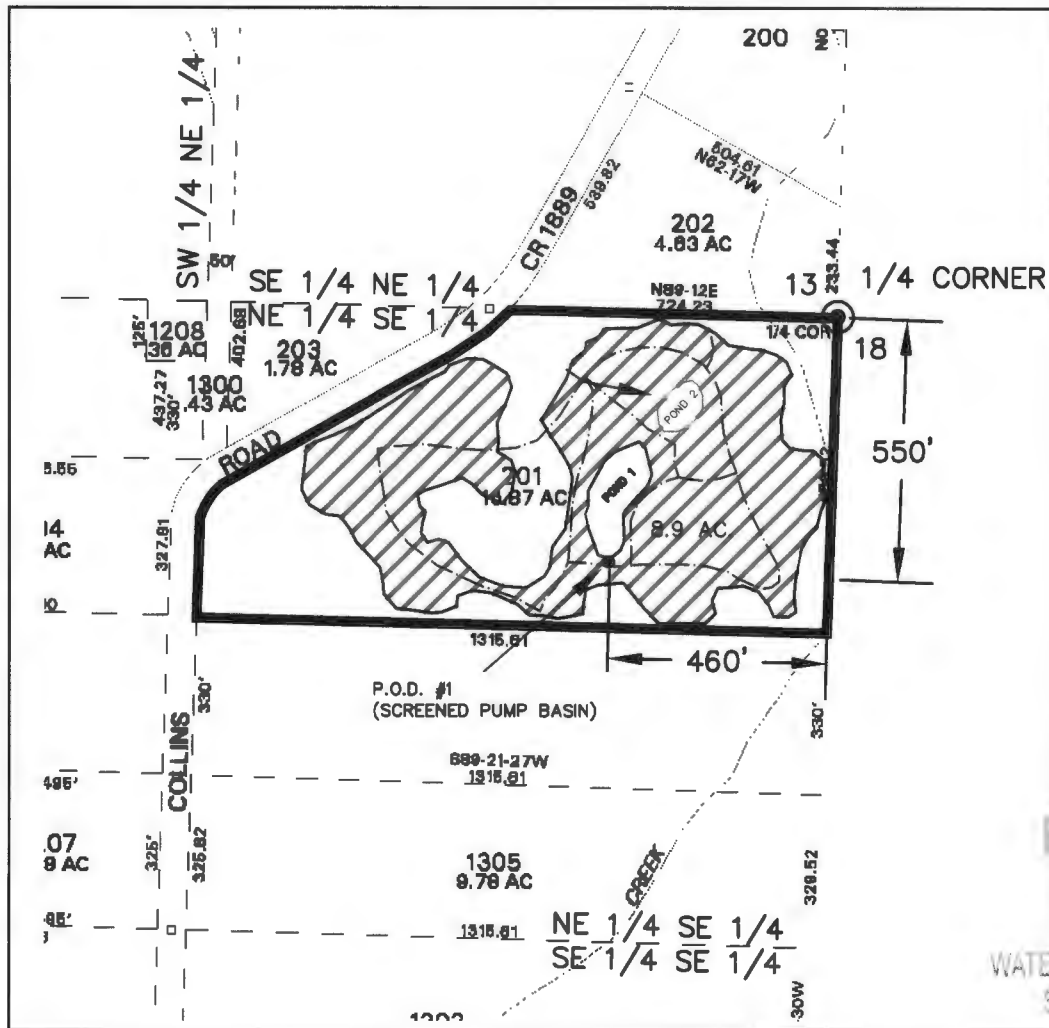


LOCATED IN THE NE 1/4 OF THE SE 1/4 OF SECTION 13. TOWNSHIP 2 NORTH,
RANGE 3 WEST, WILLAMETTE MERIDIAN.
WASHINGTON COUNTY, OREGON

APPLICATION #S-84739

PERMIT#S-53843

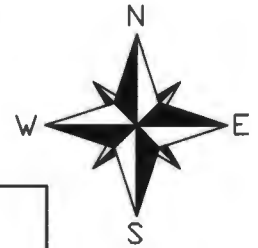

RECEIVED

DEC 28 2010

WATER RESOURCES DEPT
SALEM, OREGON



GOVERNMENT CORNER

POINT OF DIVERSION #1 IS LOCATED 550' SOUTH
AND 460' WEST OF THE 1/4 CORNER COMMON TO
SECTIONS 13 & 18.



IRRIGATION AREAS - PERMIT
S-53843 AND G-15362

EXISTING MAIN IRRIGATION PIPE LINES
2" x 3485 FEET

THIS MAP WAS PREPARED FOR THE PURPOSE OF IDENTIFYING THE LOCATION OF A WATER RIGHT ONLY AND IS NOT INTENDED TO PROVIDE LEGAL DIMENSIONS OR LOCATION OF PROPERTY OWNERSHIP LINES.


$$1 \text{ inch} = 400 \text{ ft.}$$

PREPARED FOR:

NED JAQUITH
18900 NW COLLINS RD.
NORTH PLAINS, OR 97133



EXPIRES 6/30/2011

Stuntzner



PROJECT: 310-2-047 PH.201

DRAWING: 3102047B.dwg

DRAWN BY: JMH

CHECKED BY: TMH

DATE: 8-3-2010