


CLAIM OF BENEFICIAL USE MAP
FOR
BAMBOO GARDENS

LOCATED IN THE NE 1/4 OF THE SE 1/4 OF SECTION 13. TOWNSHIP 2 NORTH,
RANGE 3 WEST, WILLAMETTE MERIDIAN.
WASHINGTON COUNTY, OREGON

APPLICATION #R-84741

PERMIT #R-13409

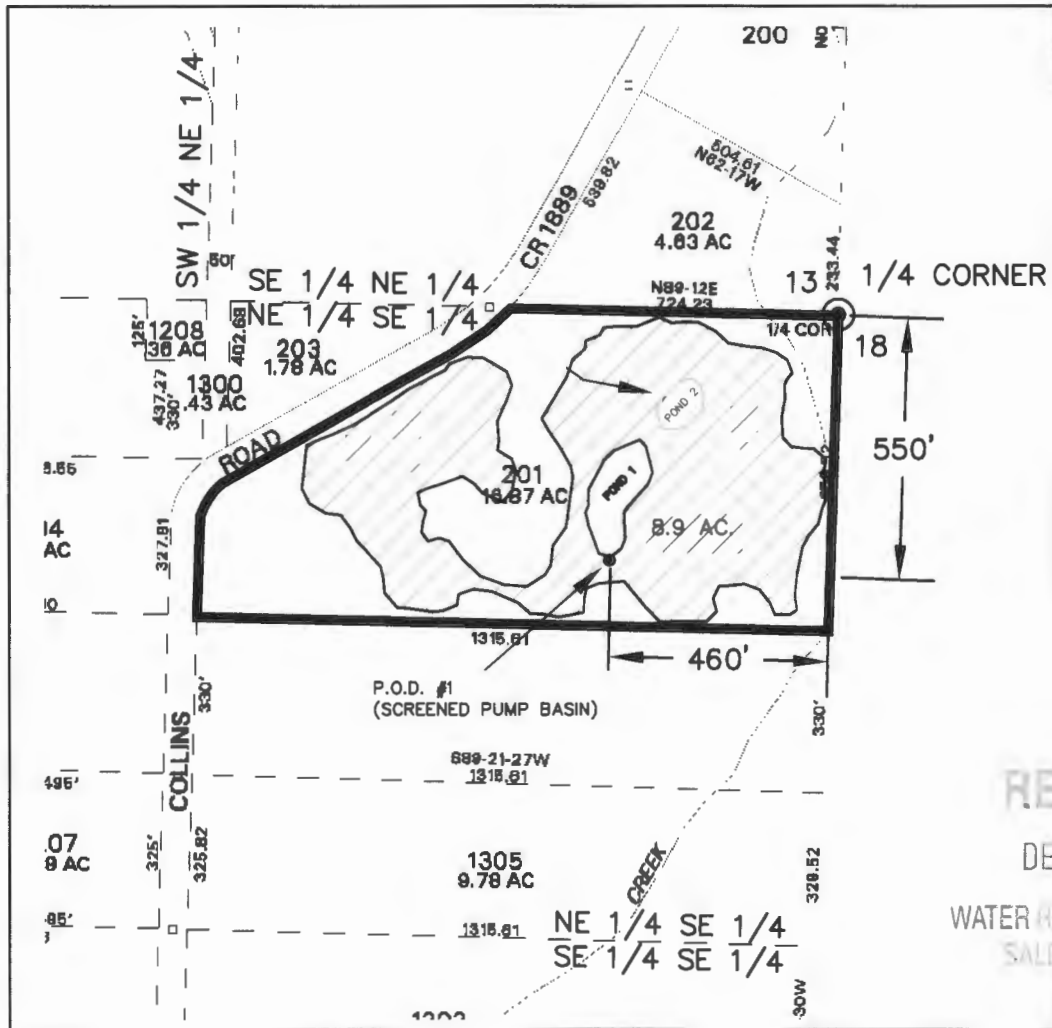

RECEIVED

DEC 28 2010

WATER RESOURCES DEPT
SALEM OREGON



GOVERNMENT CORNER



POINT OF DIVERSION #1 IS LOCATED 550' SOUTH
AND 460' WEST OF THE 1/4 CORNER COMMON TO
SECTIONS 13 & 18.



IRRIGATION AREAS - PERMIT
S-53843 & G-15362

PREPARED FOR:
NED JAQUITH
18900 NW COLLINS RD.
NORTH PLAINS, OR 97133



EXPIRES 6/30/2011



THIS MAP WAS PREPARED FOR THE PURPOSE OF
IDENTIFYING THE LOCATION OF A WATER RIGHT ONLY AND
IS NOT INTENDED TO PROVIDE LEGAL DIMENSIONS OR
LOCATION OF PROPERTY OWNERSHIP LINES.

400 0 200 400



1 inch = 400 ft.

MAP BASE:
WASHINGTON COUNTY TAX MAP
SECTION 13, T2N, R3W

PROJECT: 310-2-047 PH.201
DRAWING: 3102047B.dwg
DRAWN BY: JMH
CHECKED BY: TMH
DATE: 8-3-2010