

**FINAL PROOF SURVEY
SECTION 26
TOWNSHIP 38 SOUTH, RANGE 4 WEST
WILLAMETTE MERIDIAN, JACKSON COUNTY, OREGON**

For Marcia and Bryan Coggins
13301 Highway No. 238
Jacksonville, OR. 97530

Section 26
Township 38 South, Range 4 West
Application S-85773, Permit No. 54085

LEGEND




Date: July 21, 2004
Scale 1" = 400'

- Survey Monument
- Denotes Building

Denotes Primary Right Permit 40424, Certificate 48010, Priority Date 3/21/1976 Source Applegate River. Supplemental Right Permit 53865, Certificate 80552, Priority Date 4/15/2002, 1.936 acre feet per acre. Source Applegate Reservoir. Supplemental Right Permit 54085 Priority Date 8/11/2003, 2.419 acre feet per acre, source Applegate Reservoir.

Denotes Primary Right Permit 53865, Certificate 80552, Priority Date 4/15/2002, 1.936 acre feet per acre. Source Applegate Reservoir. Supplemental Right Permit 54085 Priority Date 8/11/2003, 2.419 acre feet per acre, source Applegate Reservoir.

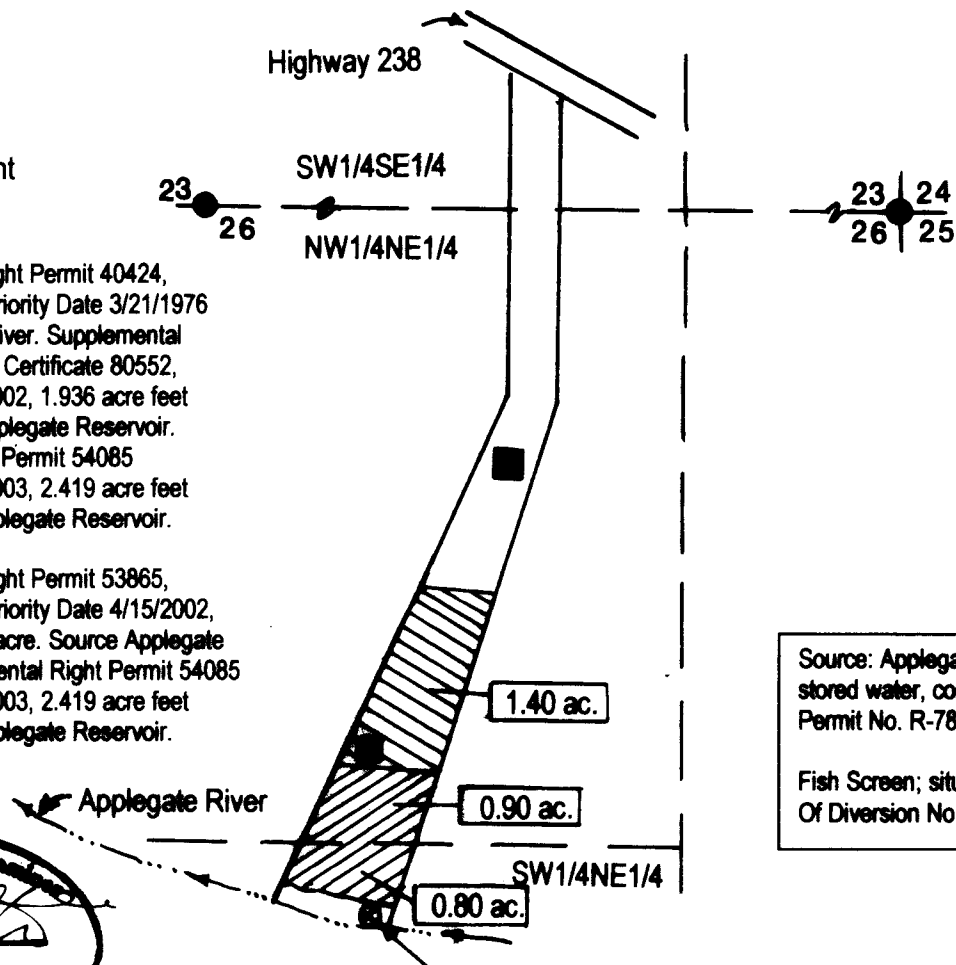

Source: Applegate Reservoir stored water, constructed Permit No. R-7810.
Fish Screen; situated at Point Of Diversion No. 1.

Point of Diversion No. 1; situated South 1480 feet and East 340 feet from the North One-Quarter Corner of Section 26, T38S, R4W. W.M.

Certified Water Right Examiner
HAROLD L. CENTER, P.L.S., C.W.R.E.
2604 David Lane – Medford, Or. 97504
541-535-6108, Fax 541-535-8752
Oregon C.W.R.E. No. 152
Certificate Renewal Date – 12-31-2005

This map was prepared for the purpose of identifying the location of a water right only and is not intended to provide legal dimensions or location of property ownership lines.