

FINAL PROOF SURVEY
 CLAIM OF BENEFICIAL USE
 SEC 32, 33, AND 34, T28S, R6W, W. M.
 SEC 3 AND 4, T29S, R6W, W. M.
 WATER RIGHTS TRANSFER T-6708
 FOR ROSEBURG FOREST PRODUCTS

SEPTEMBER 20, 2001



SCALE: 1" = 1320'

PLACE OF USE 



RECEIVED

SEP 25 2001
 SALEM OREGON

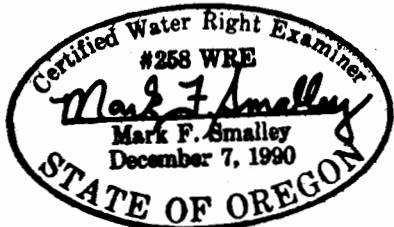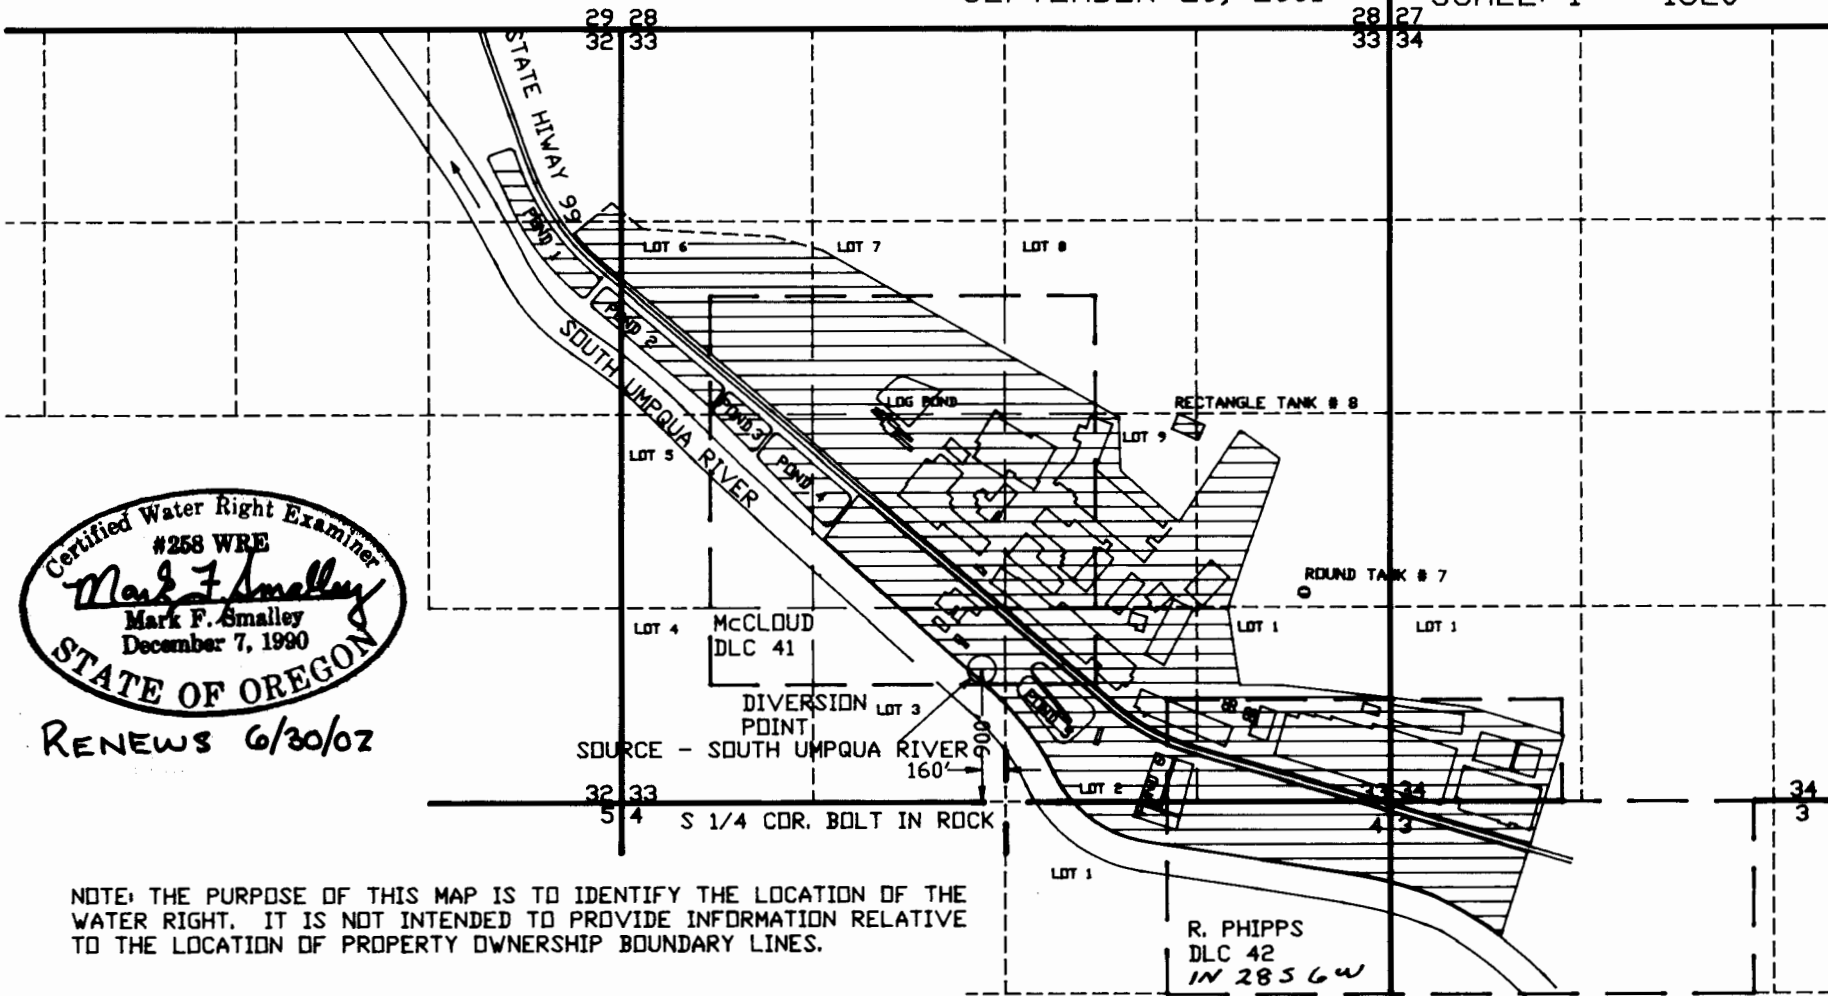

RENEWS 6/30/02

NOTE: THE PURPOSE OF THIS MAP IS TO IDENTIFY THE LOCATION OF THE WATER RIGHT. IT IS NOT INTENDED TO PROVIDE INFORMATION RELATIVE TO THE LOCATION OF PROPERTY OWNERSHIP BOUNDARY LINES.

DLC # clarification by Township added. MFB/ 12-23-15
 WRD

R. PHIPPS
 DLC 42
 IN 2856W
 R. PHIPPS
 DLC 37
 IN 2956W