

App 9881


(1) 6580
9115
10/2

MAP

Accompanying application of JAMES C. LAWRENCE of Ashland, Jackson Co, Oregon. for permit to the waters of Spring tributary to Corral Creek, Jackson Co, Oregon. for the purpose of Domestic and Irrigation use.

October 1924.

Tp 39 S. R. 4. E. W. M

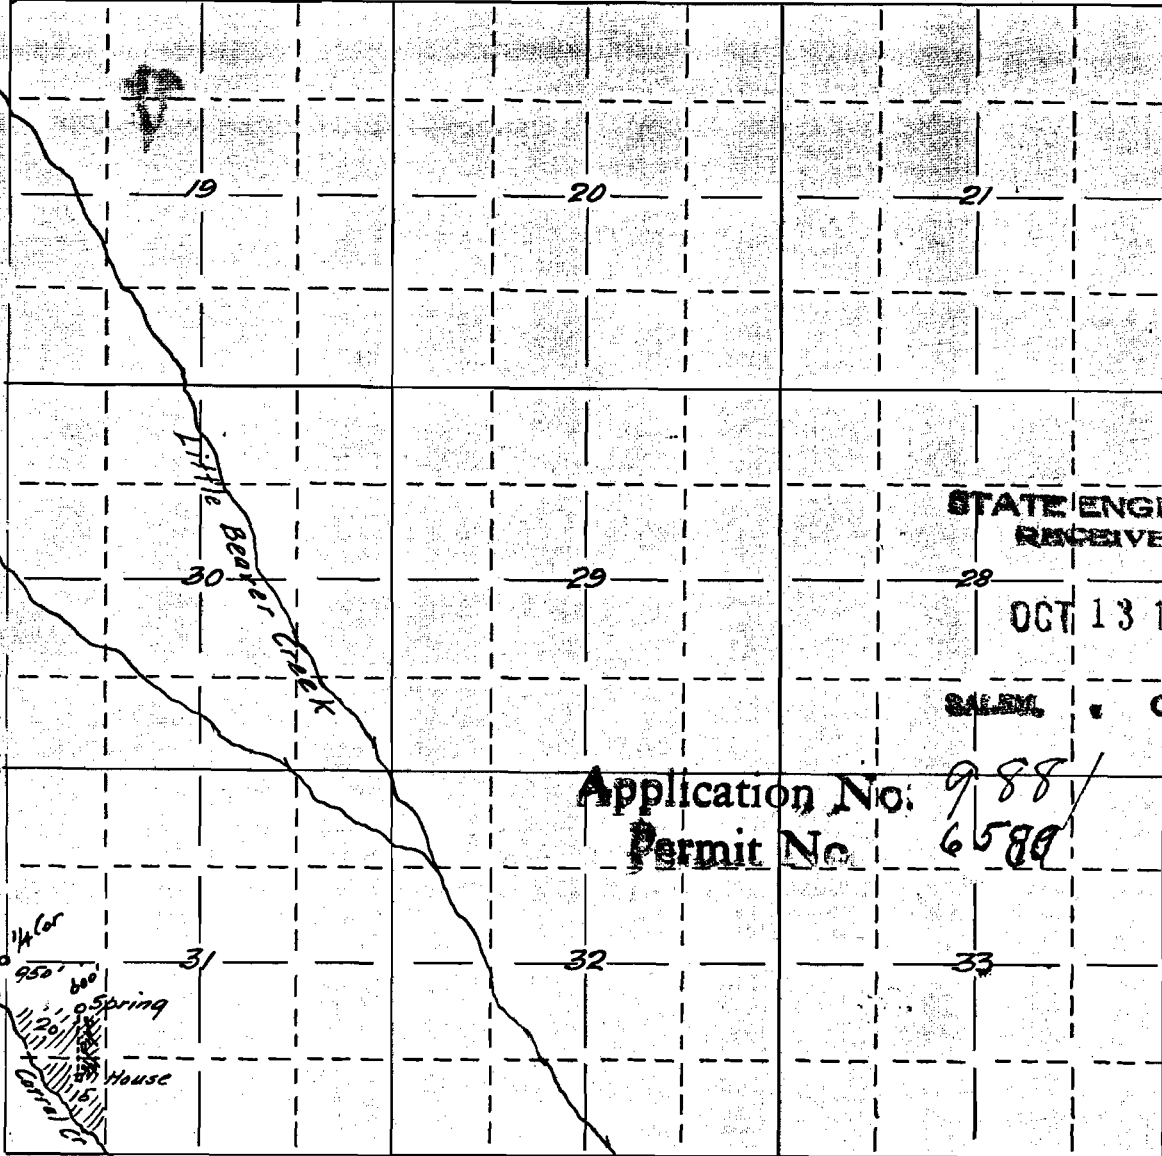

Map made from plat furnished by Mr. Lawrence. The same correctly showing source of supply and location of lands to be irrigated together with streams and ditches in immediate vicinity. Compiled by.

Fred. N. Cummings. C.E.

Ap- 9881


M.A.P.

② 6580

2 of 2

Accompanying Final Proof in the name of
James C. Lawrence of Ashland Jackson County
Oregon to the waters of unnamed Spring tributary
to Corral Creek - Jenny Creek tributary to Klamath
River, for Irrigation and Domestic purposes.

May 25, 1931

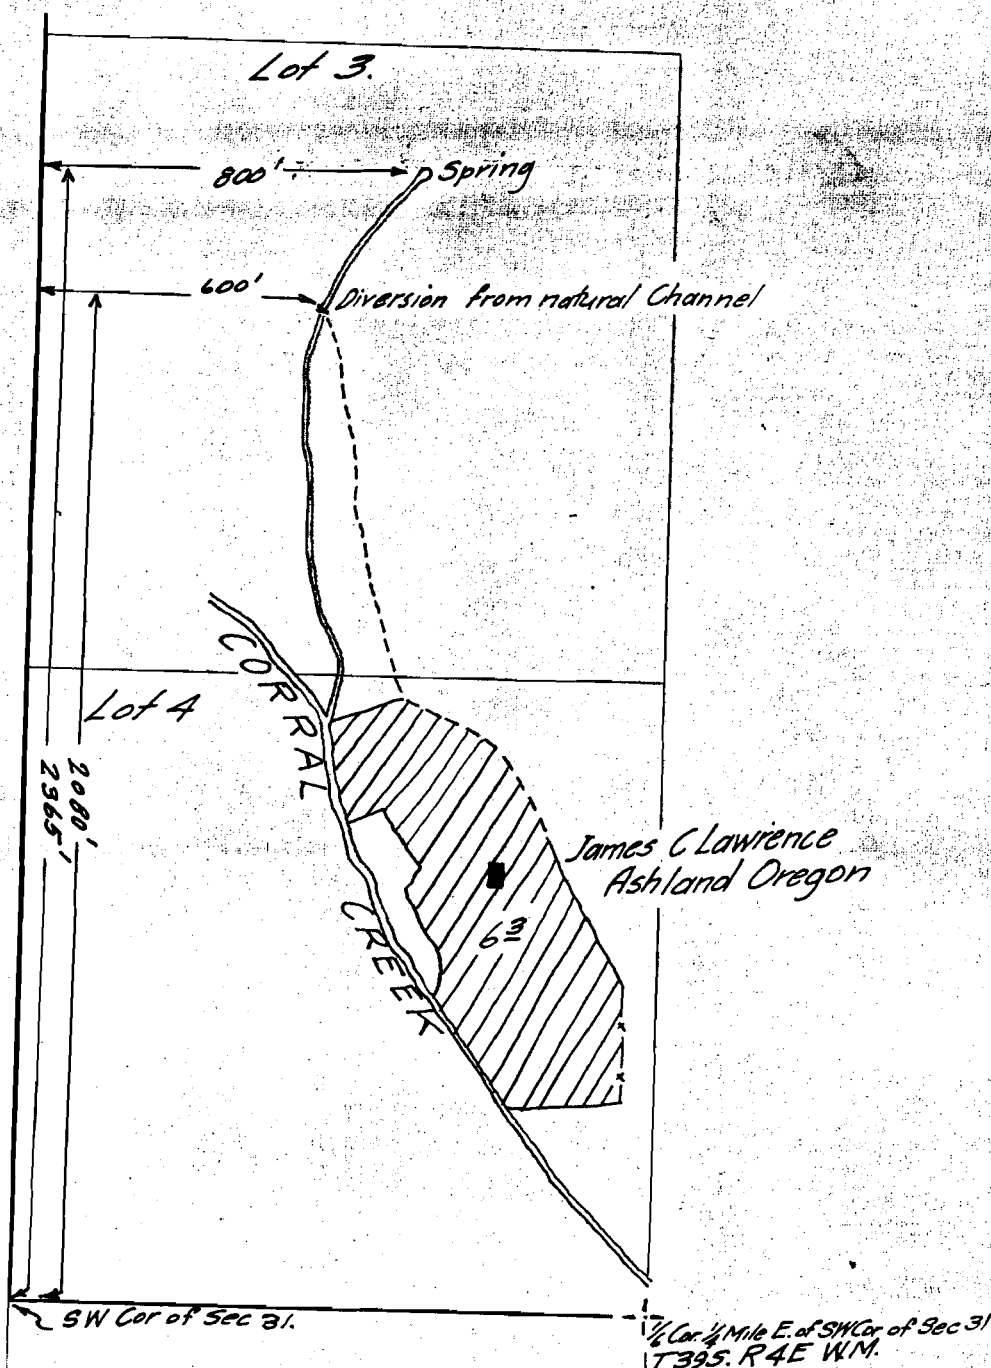

Map made from Plane Table Survey by
Chester A Cummings

App 9881
Per 6580