



T 24 S, R 33 E, WM

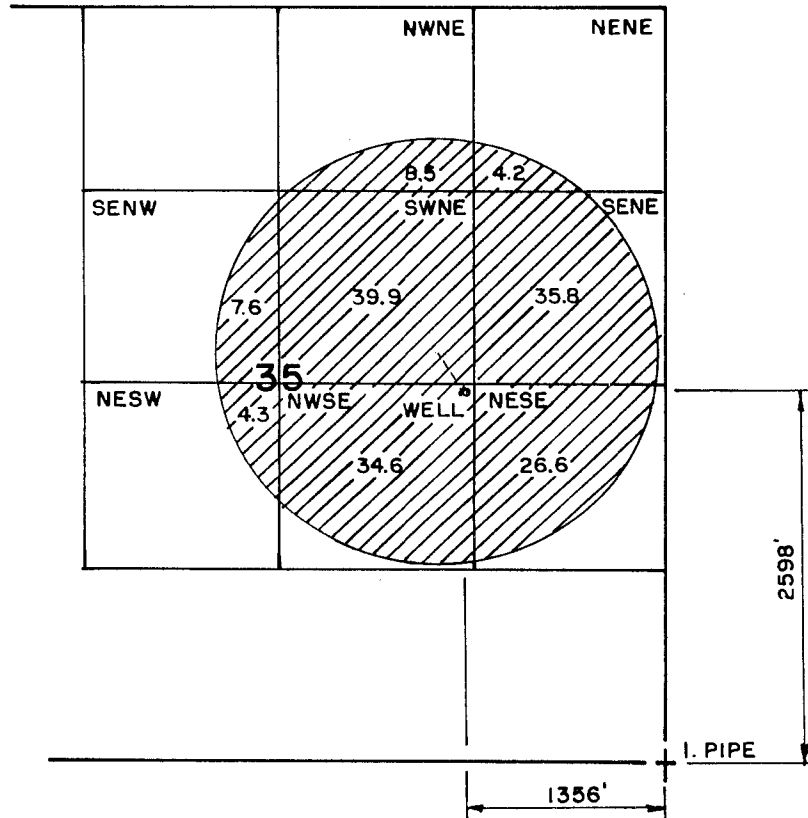

THE PURPOSE OF THIS MAP IS TO IDENTIFY THE LOCATION OF THE WATER RIGHT. IT IS NOT INTENDED TO PROVIDE INFORMATION RELATIVE TO THE LOCATION OF PROPERTY OWNERSHIP.

IRRIGATED LANDS ARE WITHIN TAX LOT 9100. LAND OWNER IS DON R. JOHNSON.

RECEIVED
 OCT 30 2002
 MAIL ROOM
 SALEM, OREGON

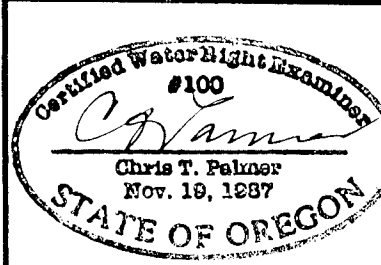


RENEW 1-1-2001

FINAL PROOF SURVEY

UNDER APPLICATION NO. G-13081 PERMIT NO. G-12961

IN THE NAME OF DON R. JOHNSON

Scale: 4 = 1 MILE	Date: 08-04-2000	Job: 1118-00
Dsn:	 M.A. PALMER & SONS, INC. ENGINEERING & SURVEYING 711 Ponderosa Village • Box 61 Burns, Oregon 97720	Sht. No.
Drn: CHRIS		of <u>1</u>
Ckd:		