


Claim of Beneficial Use in the Name of the City of Sandy Point of Diversion Map

Permit S-35394, Application S-47254
Clackamas County, Oregon
Township 2 South, Range 5 East (W.M.)

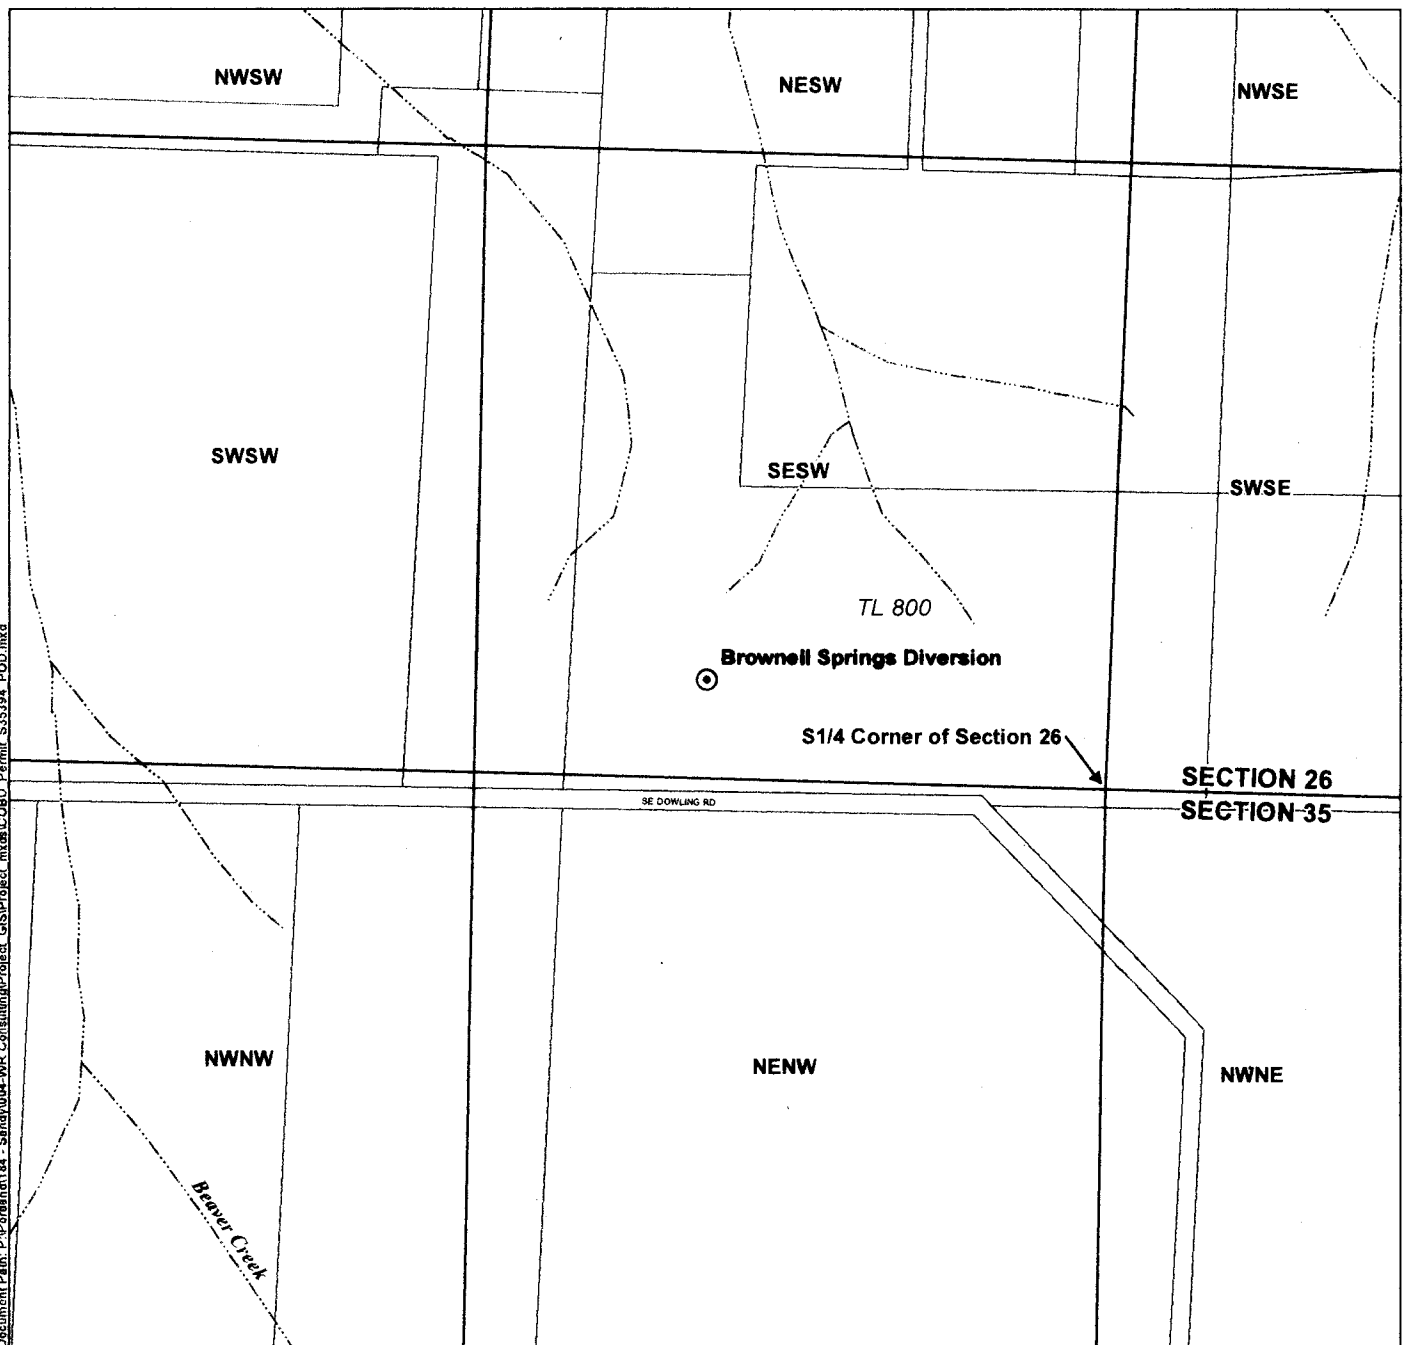


LEGEND

- ⊙ Point of Diversion (POD)
- Tax Lots
- Watercourses

POD LOCATION DESCRIPTION

Brownell Springs Diversion
830 feet West and 205 feet North from the S1/4 corner
of Section 26, Township 2 South, Range 5 East (W.M.)

Certified Water Rights Examiner Stamp

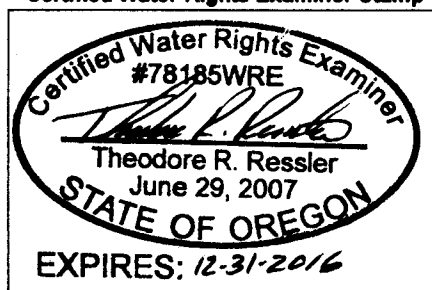

DISCLAIMER

This map was prepared for the purpose of identifying the location of a water right only and it is not intended to provide legal dimensions or location of property ownership lines.


MAP NOTES

Date: July 15, 2015
Data Sources: OWRD, Metro RLIS, USGS
Prepared By: GSI Water Solutions, Inc.



0 200 400
1 inch = 400 feet



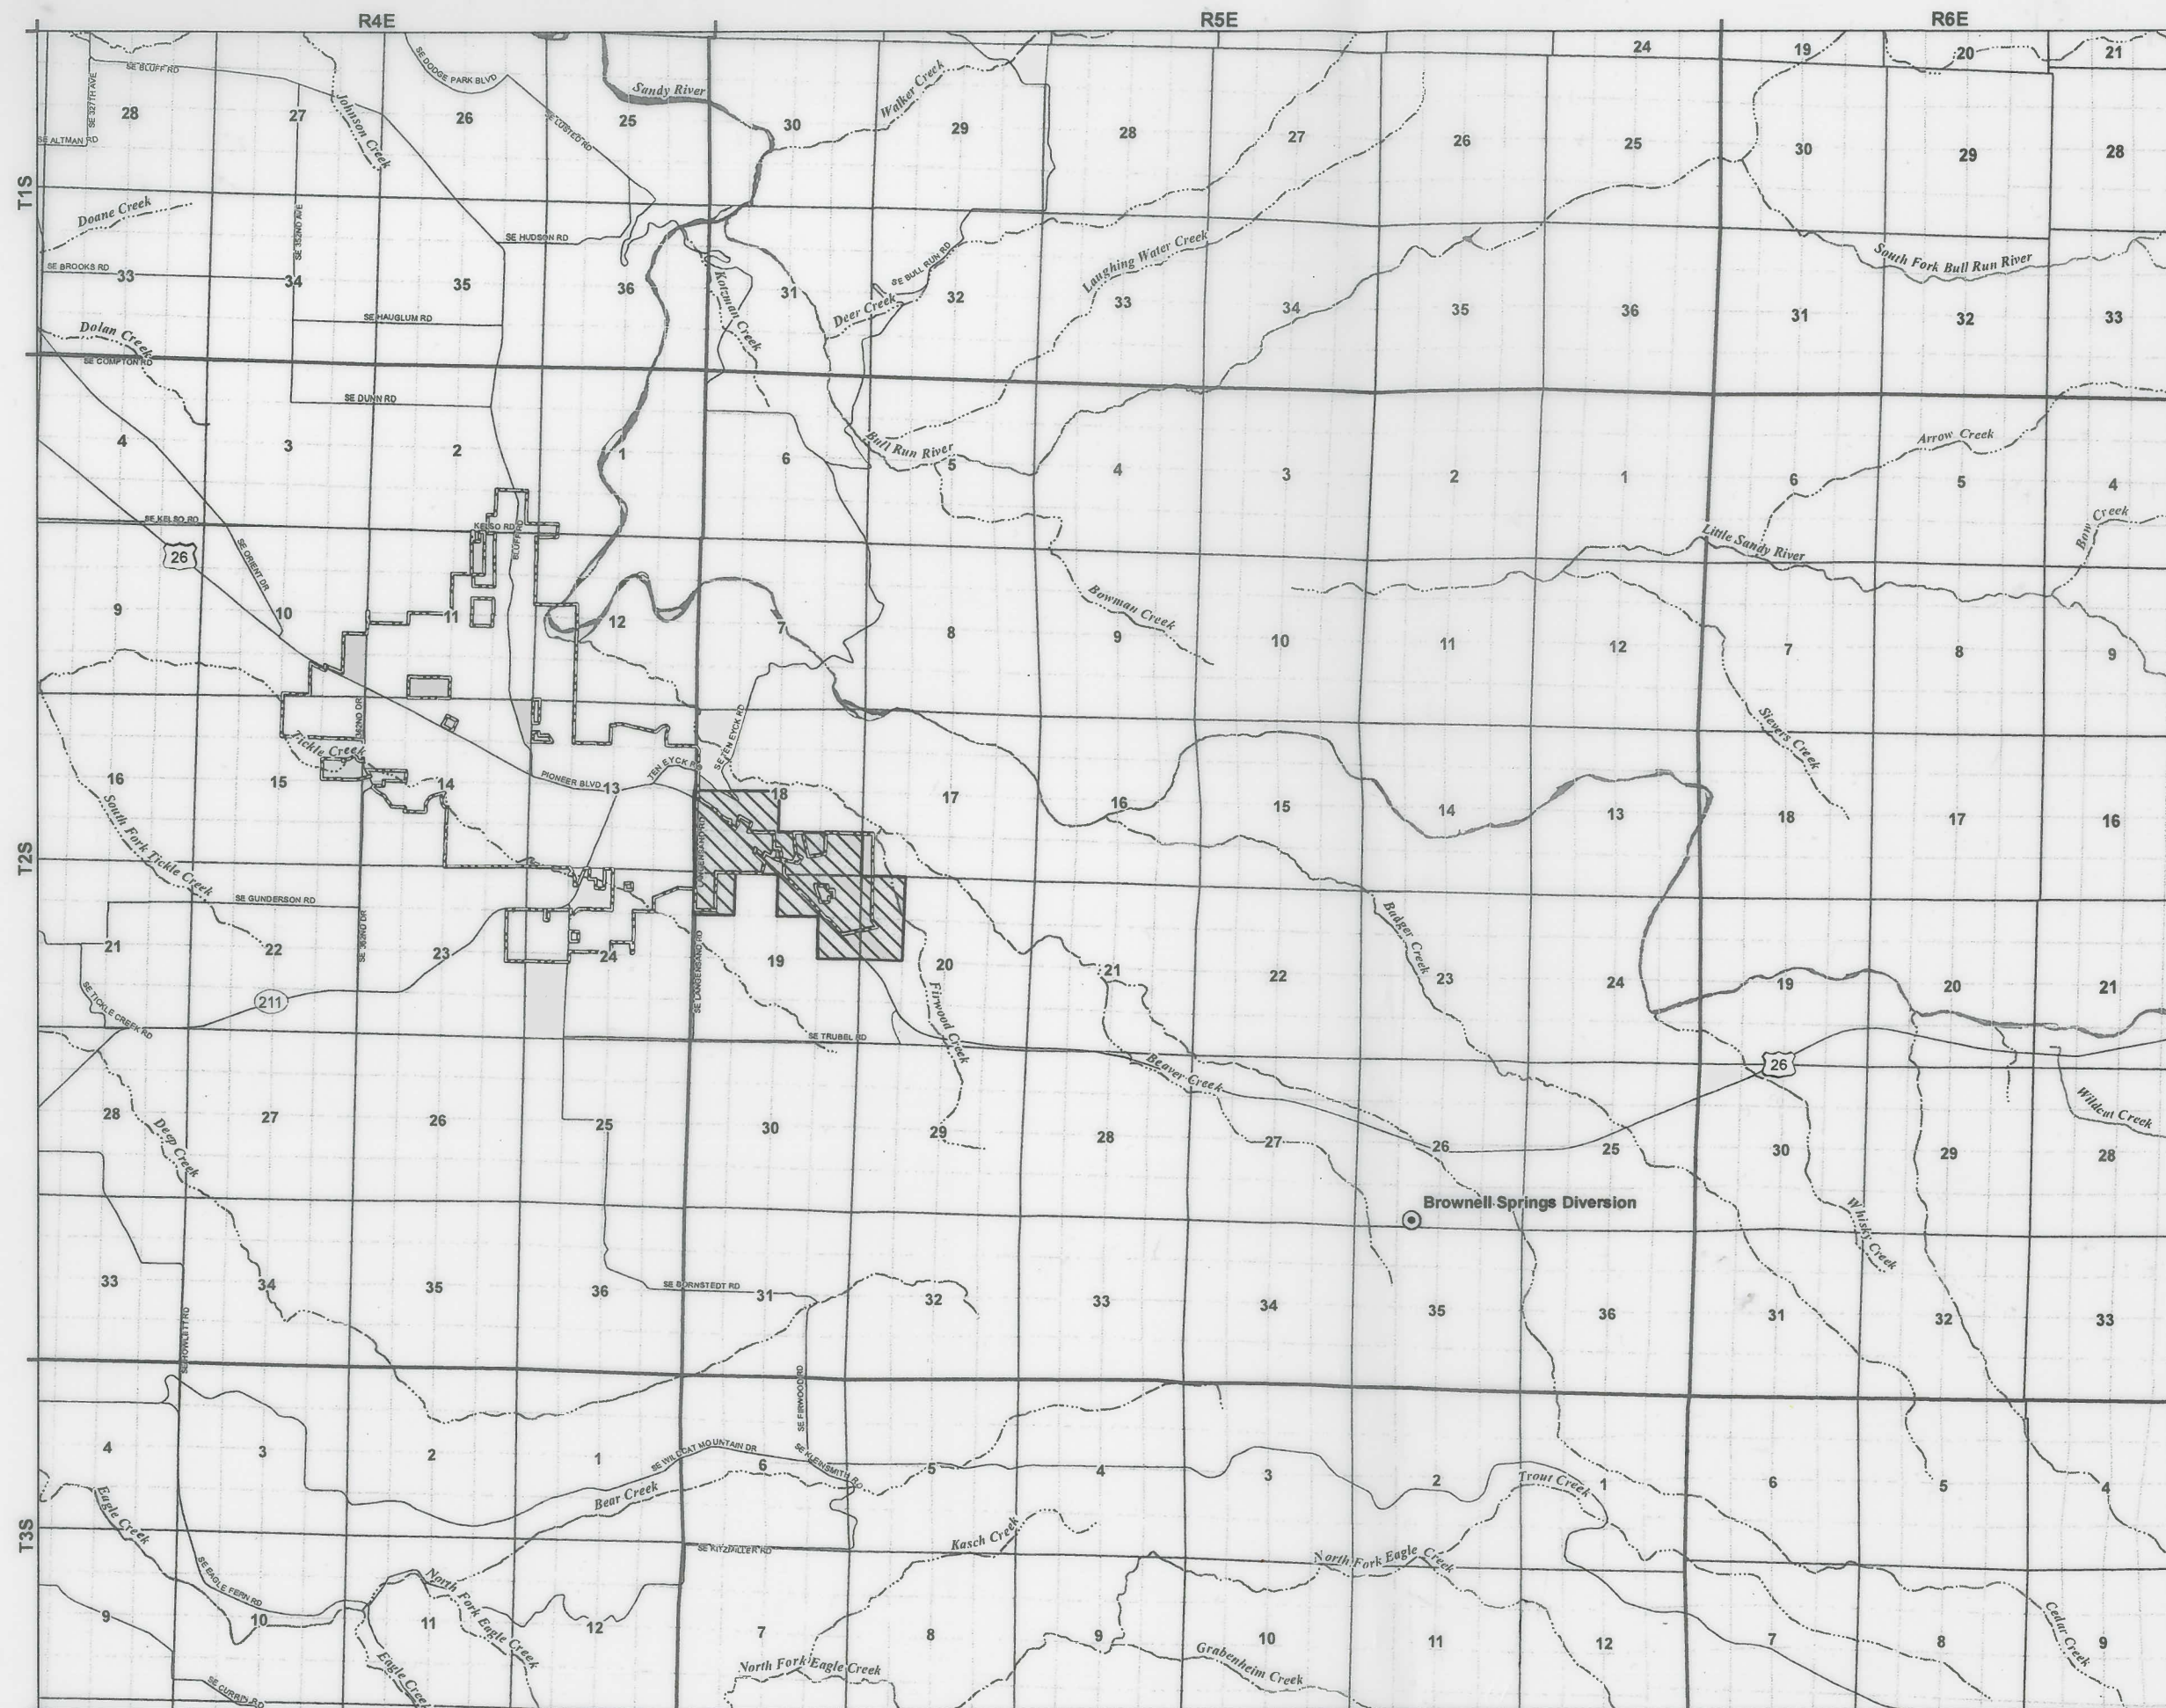

Claim of Beneficial Use in the Name of the City of Sandy


Place of Use Map

Permit S-35394, Application S-47254
Clackamas County, Oregon

LEGEND

-  Point of Diversion (POD)
-  Place of Use (POU)
-  Sandy City Limits (Service Area)
-  Major Roads
-  Watercourses
-  Waterbodies

Certified Water Rights Examiner Stamp

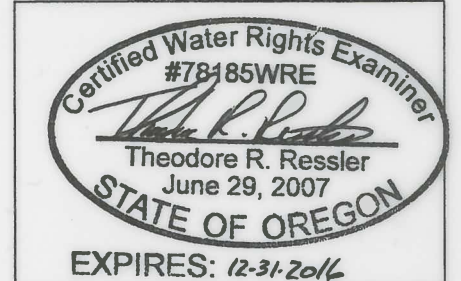


RECEIVED BY OWRD

AUG 28 2015

SALEM, OR

DISCLAIMER

This map was prepared for the purpose of identifying the location of a water right only and it is not intended to provide legal dimensions or location of property ownership lines.

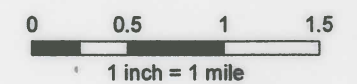**MAP NOTES:**

Date: July 15, 2015
Data Sources: OWRD, Metro RLIS, USGS

