


The purpose of this map is to identify the location of the water right. It is not intended to provide information relative to the location of property ownership boundary lines, or legal dimensions.

WATER RIGHT CLAIM OF BENEFICIAL USE MAP
Under APPLICATION NO. T-9745,
and FINAL ORDER: Special Order
Volume 68, Pages 141, 142, and 143

IN THE NAME OF JILLENE FRIES & DRAKE BUTSCH,
and WILLIAM PREDEEK
IN THE NE 1/4 OF THE NW 1/4 OF SECTION 20
TOWNSHIP 7 SOUTH, RANGE 2 EAST, W.M.

1 INCH = 200 FEET

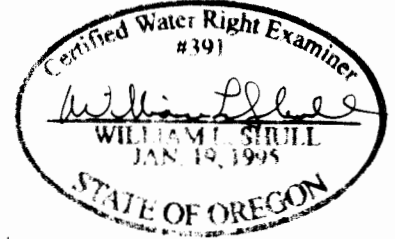

Additional Diversion Point For Domestic Use
Expanded for each of 7 Homes, 4" Pipe
From Open Creek To Collection Box
with Screen Filter

Screened Collection Box, 4" Pipe
Inflow to 2" Plastic Pipe Outflow

Shallow Fire Pond
(Mt. Angel Abbey)

2" Plastic Pipe
in Unnamed Creek

SW CORNER
SE 1/4, SW 1/4
SECTION 17

1/4 CORNER 17
20

536'

TAX LOT 200

DAVID WORLEY

TAX LOT 300

Worley House
W/Indoor Plumbing

TAX LOT 100
WILLIAM PREDEEK

Orig. Point of Diversion
for Reservoir, Certif.
No. 69720
& 14266

Orig. Reservoir

Valve Box, Hose Bibb/Faucet, and 5,
1" Distribution Lines; end of 2" Line

Buried 1" Plastic Lines - Location Approximate

Pond Outlet/
Overflow, Vert.
12" CMP. A
Staff Plate
Recorder set
in Concrete
3 Feet South
Reads
28" (Top of
Overflow)
on 9-1-07

Butsch House
W/Indoor Plumbing

Hose Bibb/Faucet

TAX LOT 400
DON BUTSCH

TAX LOT 600
DRAKE BUTSCH

TAX LOT 500
OTIS PHILLIPS

WELL No. 145489

Older Hose Bibb/Faucet, in Use

Phillips House w/Indoor Plumbing

TAX LOT 700
WILLIAM PREDEEK

Fennimore
House, Indoor
Plumbing

T.L. 800
MICK
FENNIMORE

TAX LOT 1000
ED WORLEY

Hose Bibb/Faucet

Older, Small 1960's Trail
Newer, Larger 1980's Trail

Un-named Creek