
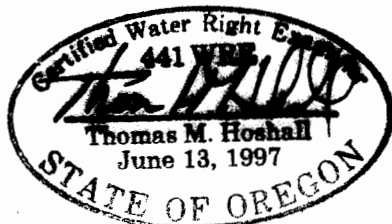


# CLAIM OF BENEFICIAL USE MAP

Located in SE¼SW¼ Section 25  
T40S, R13W, Willamette Meridian  
Curry County, Oregon

Application #S85374 - Permit #54137  
In the name of Dennis Davis and Carol Davis  
Date: January 18, 2010

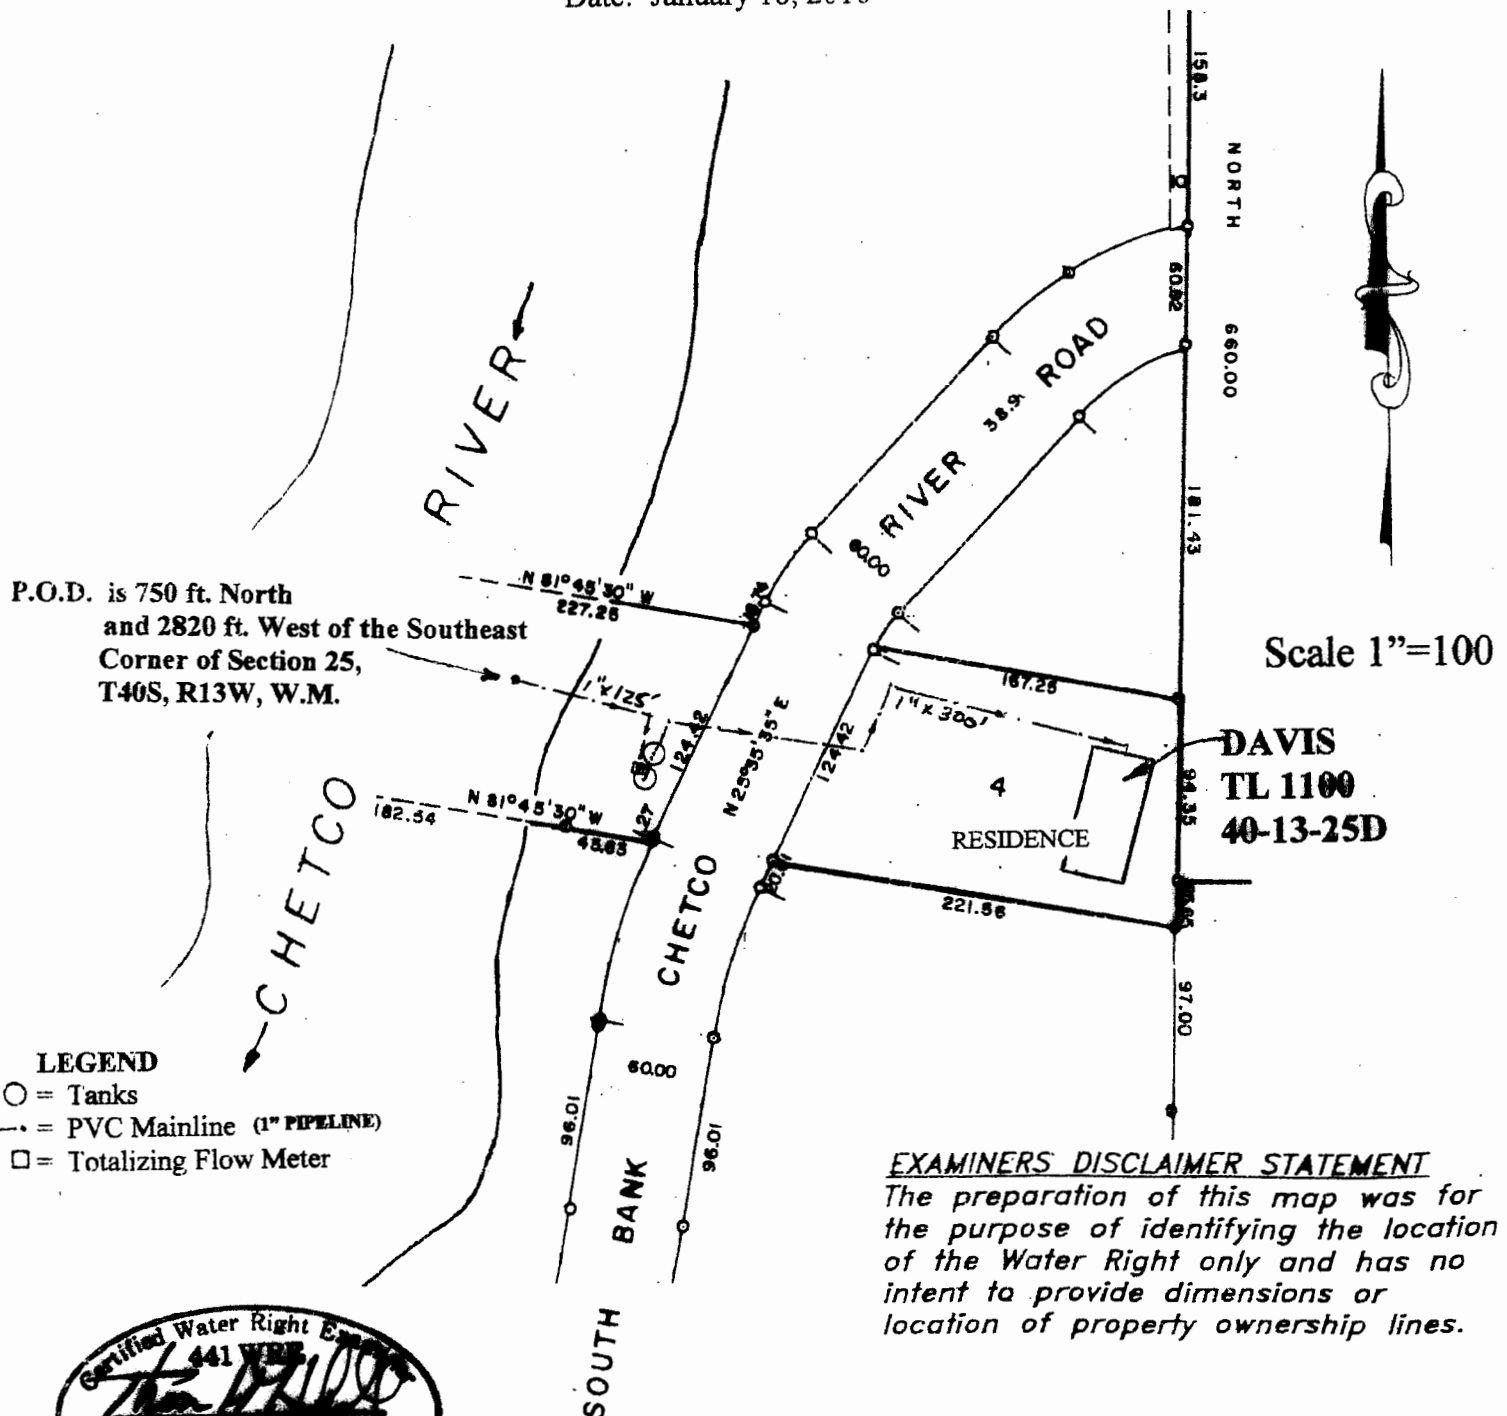

EXP. 6/30/2010

## EXAMINERS DISCLAIMER STATEMENT

The preparation of this map was for the purpose of identifying the location of the Water Right only and has no intent to provide dimensions or location of property ownership lines.

RECEIVED

FEB 01 2010

WATER RESOURCES DEPT  
SALEM, OREGON