

CLAIM OF BENEFICIAL USE MAP

AMERICAN HELLENIC EDUCATIONAL CENTER

TAX LOT 400

LOCATED IN THE SE 1/4 OF SECTION 5, T.1S., R.4E., W.M.


MULTNOMAH COUNTY, OREGON

AN UNNAMED RESERVOIR

APPLICATION NO. 73671, PERMIT NO. R11629

IRRIGATION USE

APPLICATION NO. S-73672, PERMIT NO. 51926

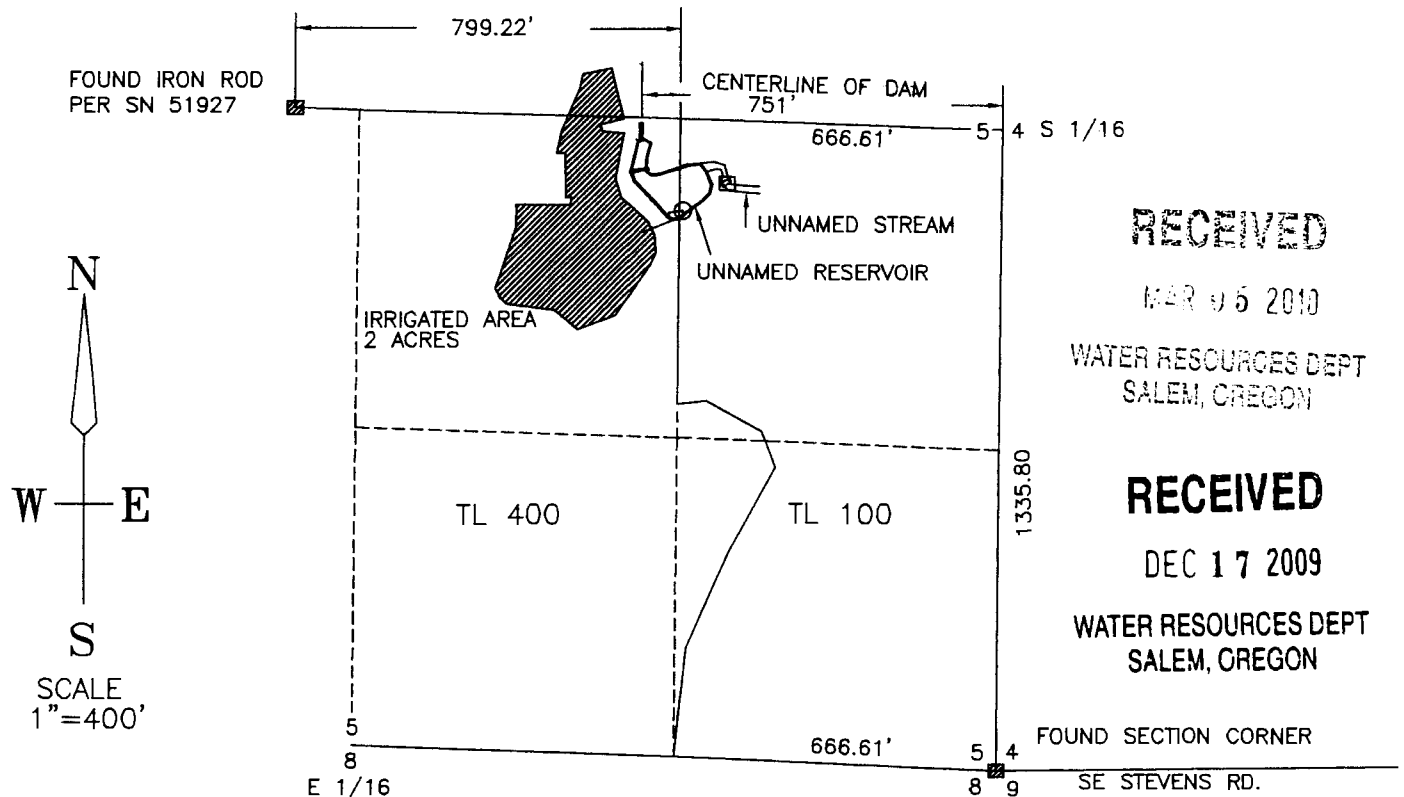

RECEIVED

MAR 05 2010

WATER RESOURCES DEPT
SALEM, OREGON

RECEIVED

DEC 17 2009


WATER RESOURCES DEPT
SALEM, OREGON

NOTE: THE PREPARATION OF THIS MAP WAS FOR THE PURPOSE OF IDENTIFYING THE LOCATION OF THE WATER RIGHT AND HAS NO INTENT TO PROVIDE DIMENSIONS OR LOCATIONS OF PROPERTY OWNERSHIP LINES.

⊙ = Point of Diversion for irrigation use.
5 HP pump with small mesh fish screen attached

□ = Point of Diversion for Reservoir use.

CLIENT:
AMERICAN HELLENISTIC EDUCATIONAL CENTER
3214 SE STEVENS RD.
CORBETT, OREGON

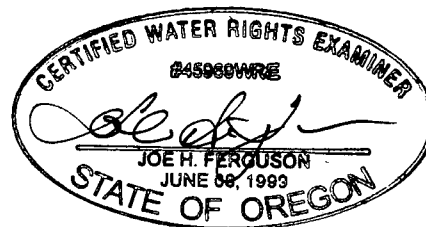

Ferguson Land Surveying, Inc.

646 SE 106TH AVE. PORTLAND, OR 97216

SHEET NO. 1 OF 1

JOB NO. 09-027 CBU