


Claim of Beneficial Use in the Name of the City of Sandy Point of Diversion Map

Permit S-36601, Application S-48840
Clackamas County, Oregon
Township 2 South, Range 6 East (W.M.)

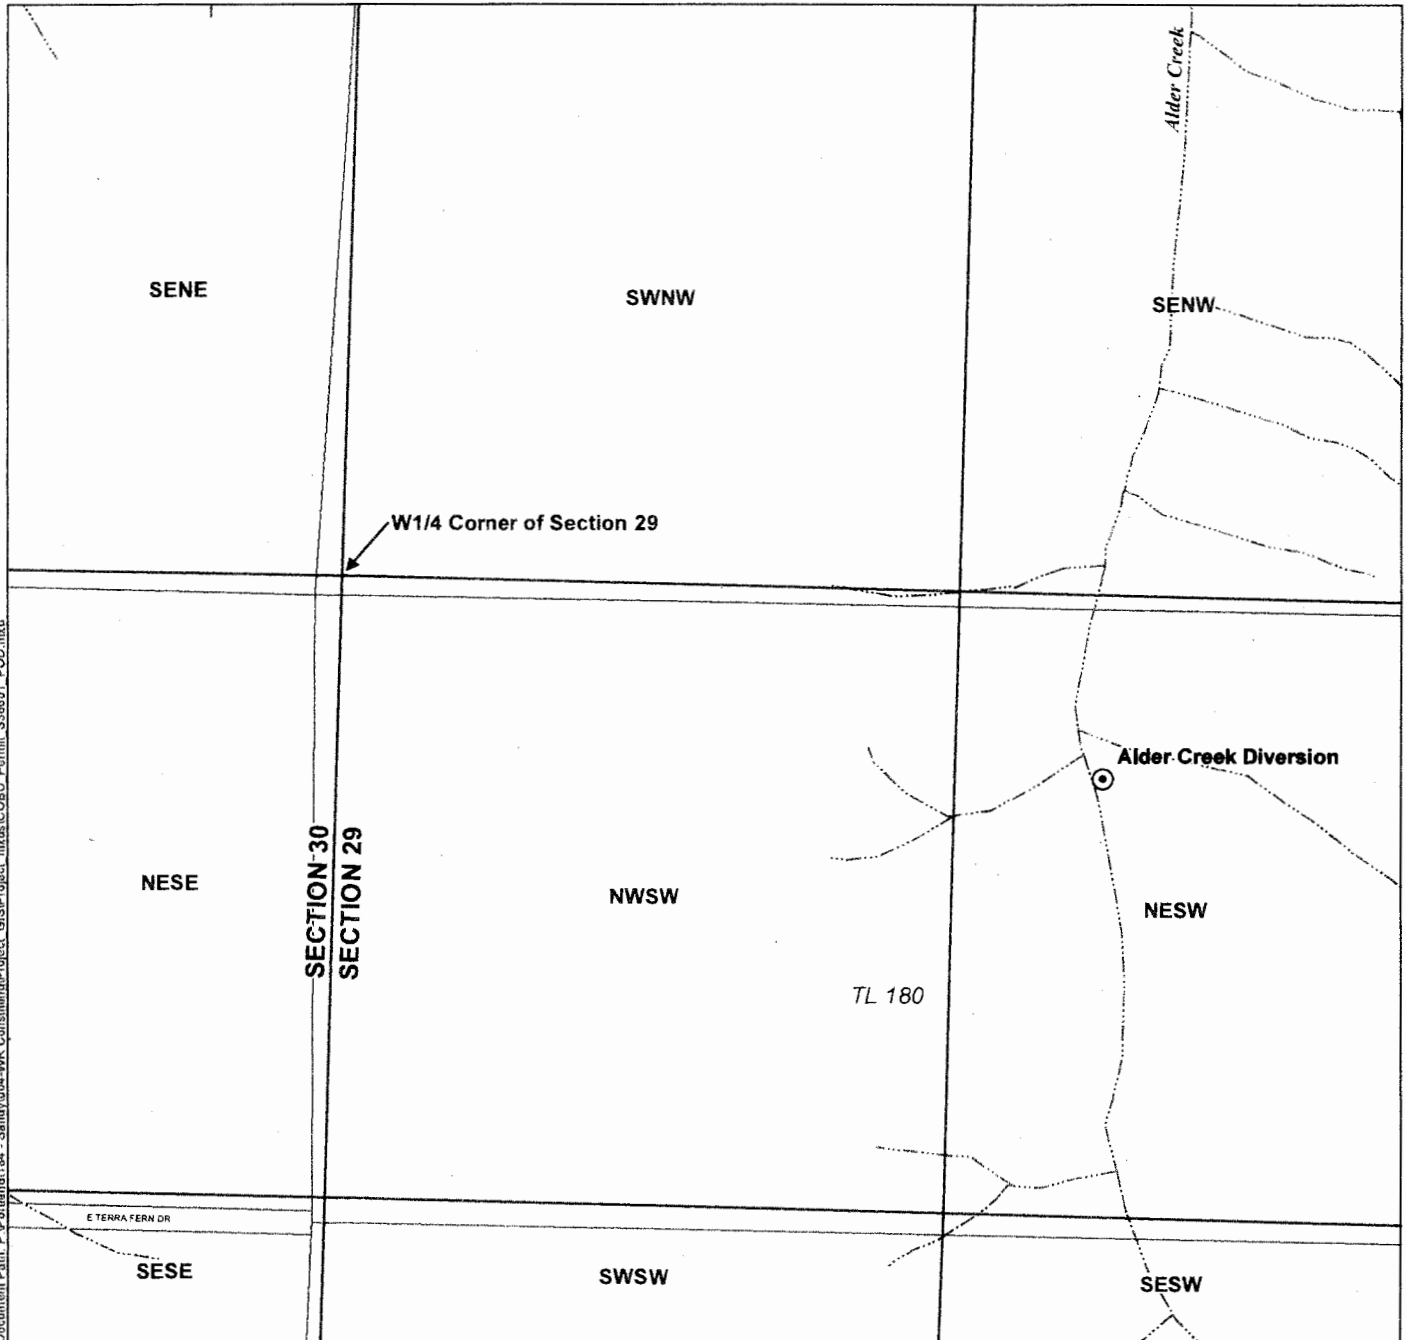


LEGEND

○ Point of Diversion (POD)

□ Tax Lots

--- Watercourses

Certified Water Rights Examiner Stamp

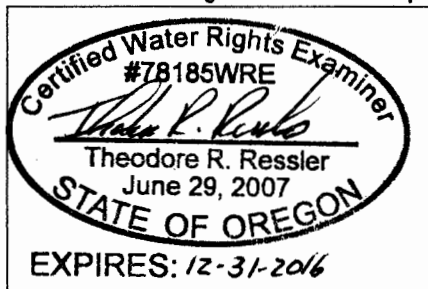

DISCLAIMER

This map was prepared for the purpose of identifying the location of a water right only and it is not intended to provide legal dimensions or location of property ownership lines.

MAP NOTES

Date: July 15, 2015
Data Sources: OWRD, Metro RLIS, USGS
Prepared By: GSI Water Solutions, Inc.

POD LOCATION DESCRIPTION

Alder Creek Diversion
1,595 feet East and 385 feet South from the W1/4 corner of
Section 29, Township 2 South, Range 6 East (W.M.)

