



TOWNSHIP 1 SOUTH, RANGE 4 EAST, W.M.

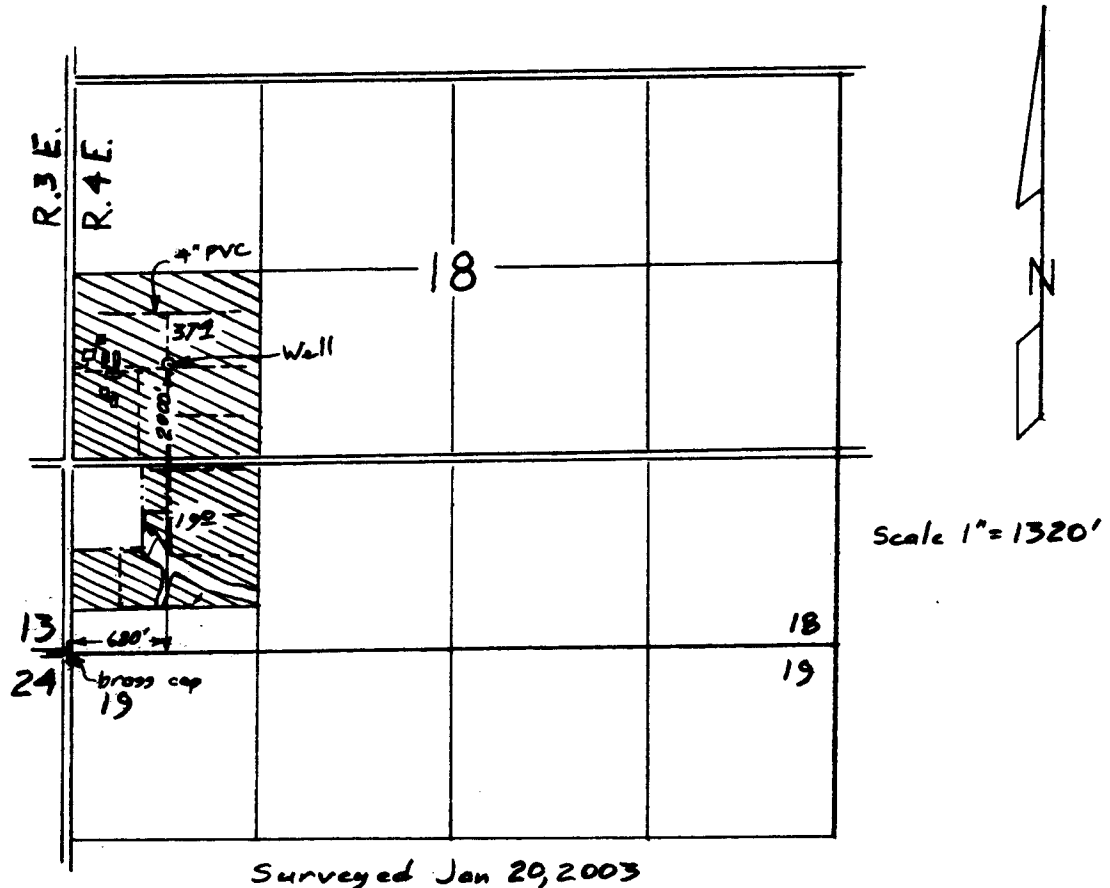

Surveyed Jan 20, 2003

Claim of Beneficial Use
for
PARK'S NURSERY

App G-12749
Per G-12343

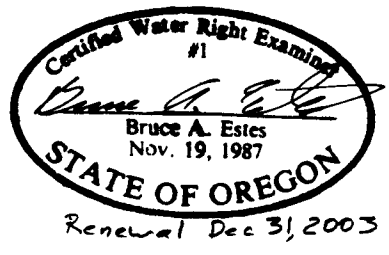

This map is for the purpose of locating a water right only and has no intent to provide legal dimensions or the location of property lines.

ESTES SURVEYS
 PO Box 17519 60382 Arnold Rd
 Salem, OR 97305-7519 Bend, OR 97702
 (503) 585-7593 (541) 382-7391