

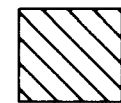


Claim Of Beneficial Use Map for T-11742 Township 17 S Range 6 W Sections 29, 30, 31 and 32

THIS MAP IS NOT INTENDED TO PROVIDE LEGAL DIMENSIONS OR LOCATIONS OF PROPERTY OWNERSHIP LINES

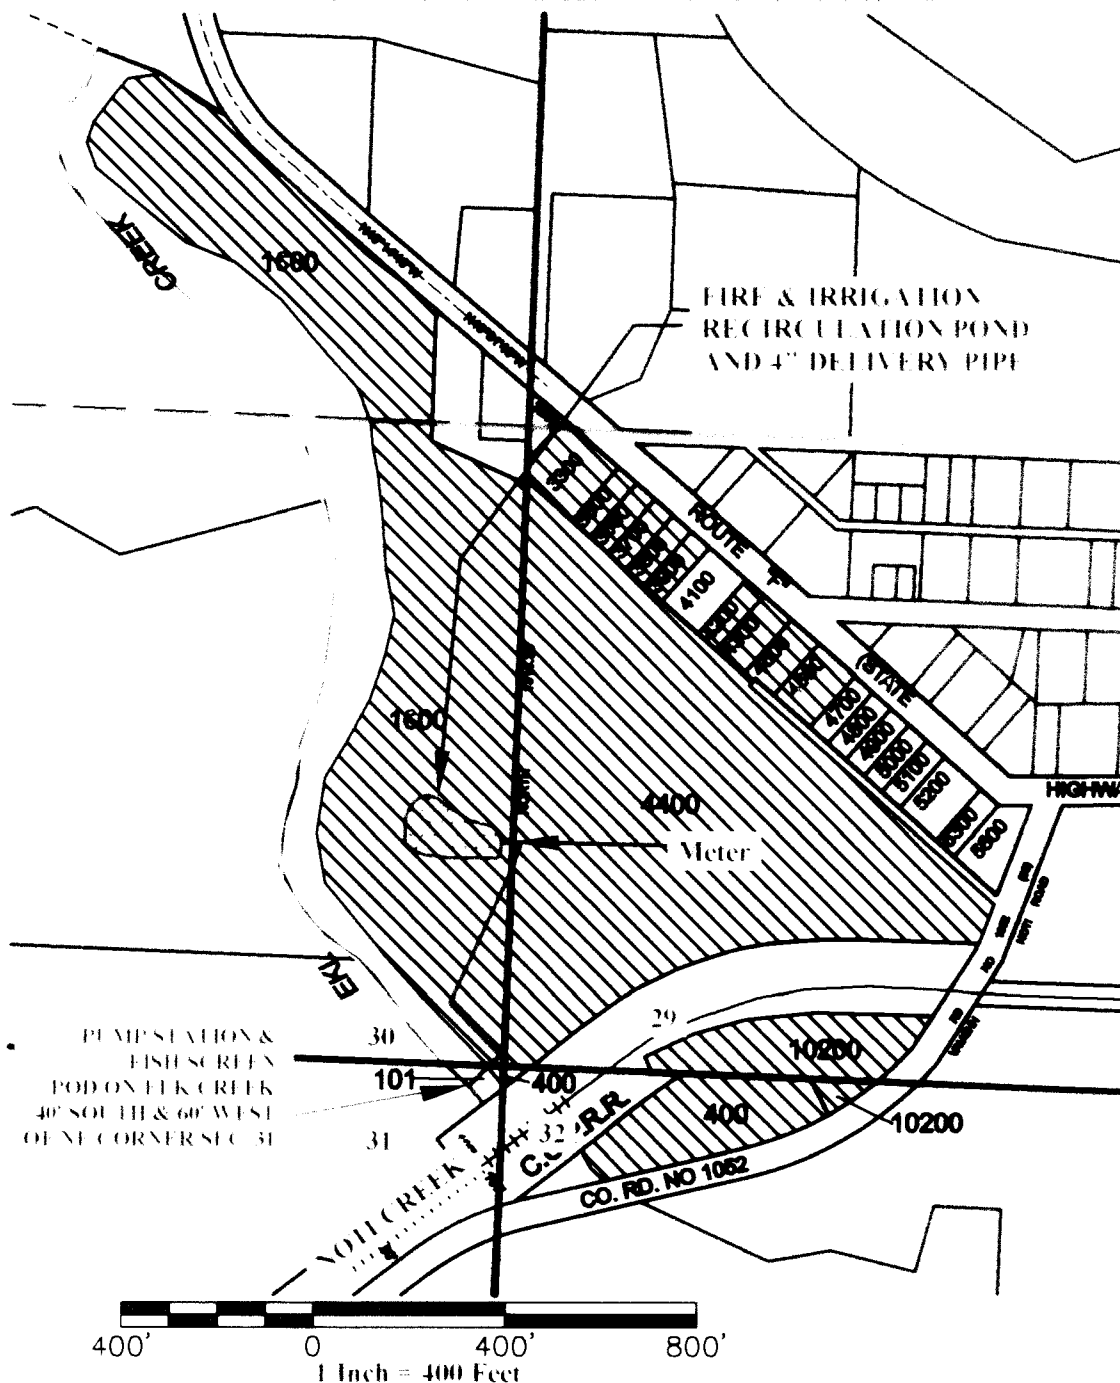


Area of Use
T-11742

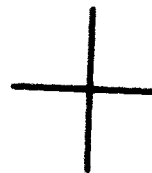

Section Boundaries

Section Boundaries

Pumping and
Recirculation Pond

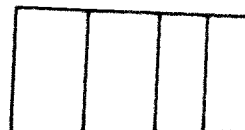


Tax Lot Boundaries

Place Of Use for T-11742				
Tax Lot	TRS	1/4 1/4 SECTION	Acres of Use by Tax Lot	Total Acres in Tax Lot
1706293003300	17 s 6 w 29	SW SW	0.49	0.49
1706293003500	17 s 6 w 29	SW SW	0.17	0.17
1706293003600	17 s 6 w 29	SW SW	0.17	0.17
1706293003700	17 s 6 w 29	SW SW	0.17	0.17
1706293003800	17 s 6 w 29	SW SW	0.17	0.17
1706293003900	17 s 6 w 29	SW SW	0.17	0.17
1706293004200	17 s 6 w 29	SW SW	0.17	0.17
1706293004300	17 s 6 w 29	SW SW	0.26	0.26
1706293004400	17 s 6 w 29	SW SW	13.16	13.16
1706293004500	17 s 6 w 29	SW SW	0.25	0.25
1706293004600	17 s 6 w 29	SW SW	0.32	0.32
1706293010200	17 s 6 w 29	SW SW	1.53	1.53
1706293010200	17 s 6 w 32	NW NW	0.13	0.13
1706300001600	17 s 6 w 30	SE SE	8.59	10.82
1706300001600	17 s 6 w 30	NE SE	5.28	6.31
1706310000101	17 s 6 w 31	NE NE	0.02	0.13
1706320000400	17 s 6 w 32	NW NW	1.56	1.71
Total			32.61	36.13

RECEIVED

SEP. 22 2015

OWRD

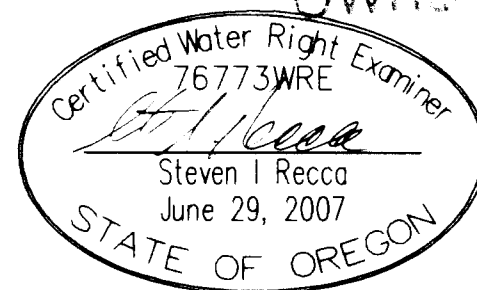

EXPIRATION DATE: 12/31/16

EGR & Associates, Inc.