


CLAIM OF BENEFICIAL USE FINAL PROOF MAP
 LOCATED IN THE NE¼ NE¼ OF SECTION 29
 TOWNSHIP 23 SOUTH, RANGE 10 WEST, W.M.
 COOS COUNTY, OREGON
 APPLICATION S-67940 PERMIT S-54394

1" = 400 FEET

PREPARED FOR: Oregon Department of Forestry
 PREPARED BY: DENNIS GOUDE
 DATE PREPARED: January 11, 2008

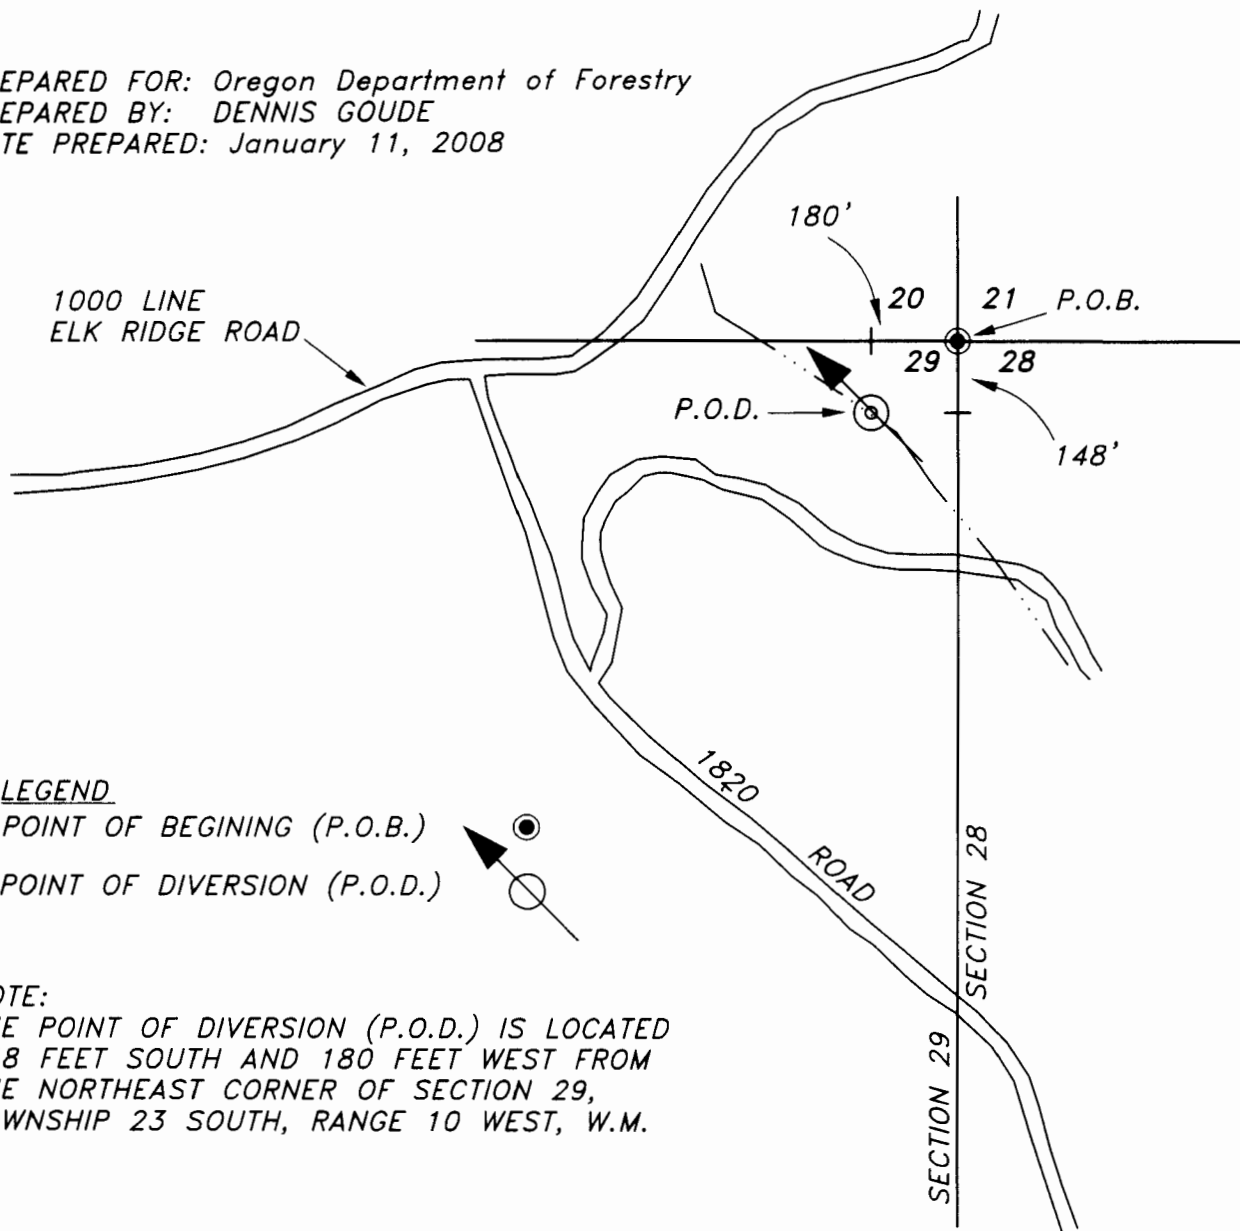

LEGEND

POINT OF BEGINING (P.O.B.)

POINT OF DIVERSION (P.O.D.)


NOTE:

THE POINT OF DIVERSION (P.O.D.) IS LOCATED
 148 FEET SOUTH AND 180 FEET WEST FROM
 THE NORTHEAST CORNER OF SECTION 29,
 TOWNSHIP 23 SOUTH, RANGE 10 WEST, W.M.

RECEIVED

JAN 12 2008

MAILED 1000
 JAN 12 2008
 SALEM, OREGON

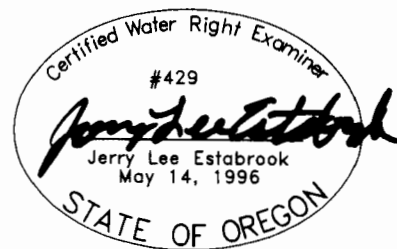

EXPIRES 12/31/2009

**Stuntzner Engineering
 & Forestry, L.L.C.**

ENGINEERING • LAND SURVEYING • FORESTRY
 PLANNING WATER RIGHTS

705 South 4th St.
 Post Office Box 118
 Coos Bay, Oregon 97420
 Phone: (541) 267-2872
 Fax: (541) 267-0588

DISCLAIMER STATEMENT

The preparation of this map was for the purpose of
 identifying the location of the Water Right only and
 has no intent to provide dimensions or location of
 property ownership lines.