


THIS MAP IS PREPARED ONLY FOR USE IN IDENTIFYING THE LOCATION OF A WATER RIGHT.
NO USE IS INTENDED TO PROVIDE LEGAL DIMENSIONS OR THE LOCATION OF PROPERTY LINES

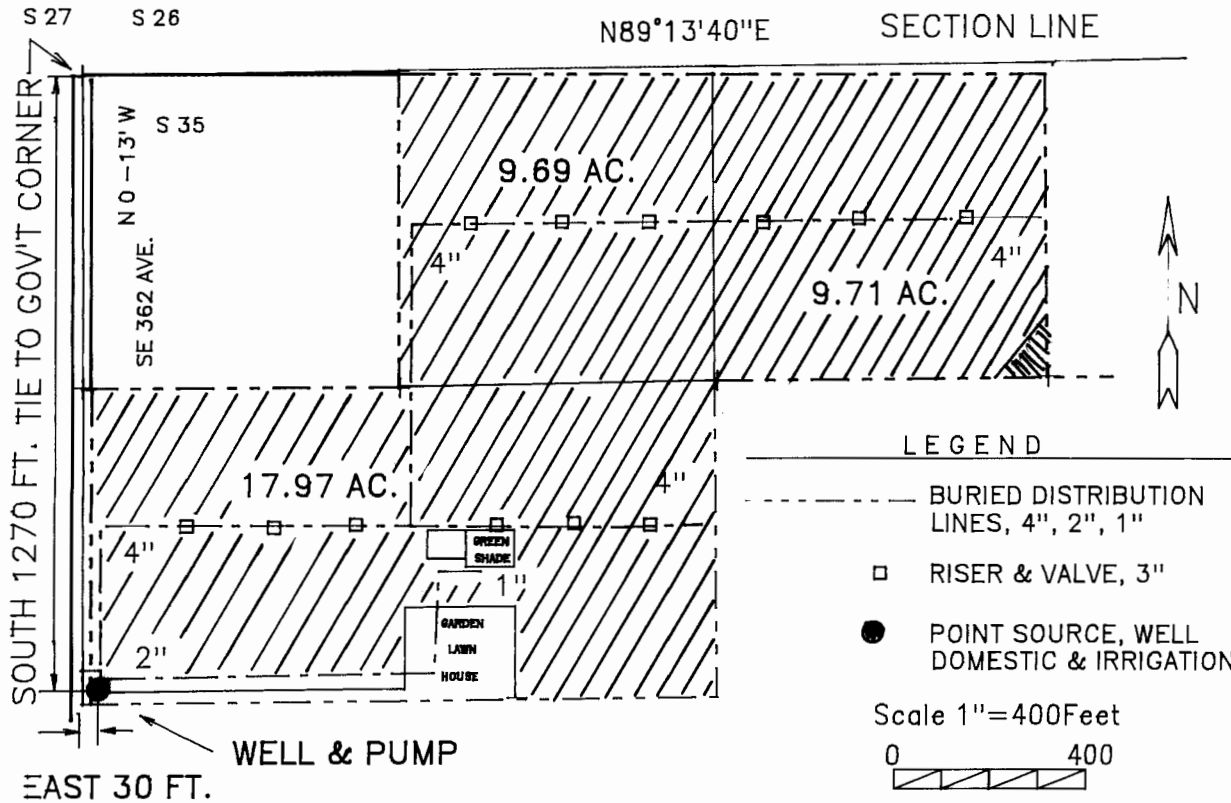

T.1 S., R.4 E., W.M., SEC 35, NW
IN: NW NW & NE NW CLACKAMAS CO.
CLAIM OF BENEFICIAL USE
FOR
JAMES KRUEGER
UNDER
APPLICATION G-14036, PERMIT G-12968

John C. Richmond