


CLAIM OF BENEFICIAL USE MAP
DENNIS & JUDY BOTTEM AND MARK & JENNIFER LYDON

APPLICATION FILE #S-87253; PERMIT #S-54605

A PORTION OF SECTION 8
TOWNSHIP 18 SOUTH, RANGE 5 WEST, W.M.
LANE COUNTY, OREGON

CENTER
SECTION


1/4 COR

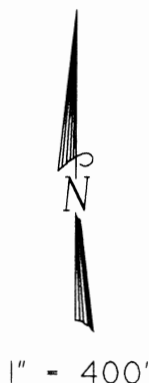

EXISTING DOWNSTREAM
RESERVOIR NOT A PART
OF THIS REQUEST

MAP 18-05-08
TAX LOT 602

JOB SWALE CREEK

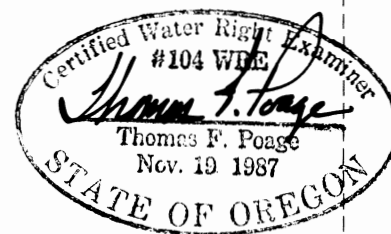

Lot 4

BARN
GARAGE
EX HOUSE WITH
1/4 ACRE OF
IRRIGATED LAWN

POD #1
METER
1" PIPE

POD #2
& PUMP

RESERVOIR NO. 5

POINT OF DIVERSION #1
(POND OUTLET): 1,150
FEET NORTH & 1,290
FEET WEST OF THE SE
CORNER OF SECTION 8

POINT OF DIVERSION #2
(INTAKE): 820 FEET
NORTH & 1,370 FEET
WEST OF THE SE CORNER
OF SECTION 8

POINT OF APPROPRIATION (DWELLING):
850 FEET NORTH & 1,580 FEET WEST OF
THE SE CORNER OF SECTION 8

THERE IS A PUMP AND FISH SCREEN AT
POD #2. THE PUMP IS IN A STRUCTURE
ON THE BANK OF THE RESERVOIR AND
THE FISH SCREEN IS ON THE INTAKE.
THERE IS ALSO A TOTALIZING FLOW
METER IN A STRUCTURE NEXT TO THE
EXISTING HOUSE.

PLACE OF USE IS
LOCATED ENTIRELY
WITHIN SW 1/4 OF
SE 1/4 OF SEC. 8

1/4 COR

8 9

17 16

THIS MAP IS NOT INTENDED TO PROVIDE LEGAL DIMENSIONS OR
LOCATIONS OF PROPERTY OWNERSHIP LINES.