


Willow Valley Irrigation District
Township 40 South, Range 14 East, W.M.

Final Proof for Permit 51109

1 inch = 1,320 feet

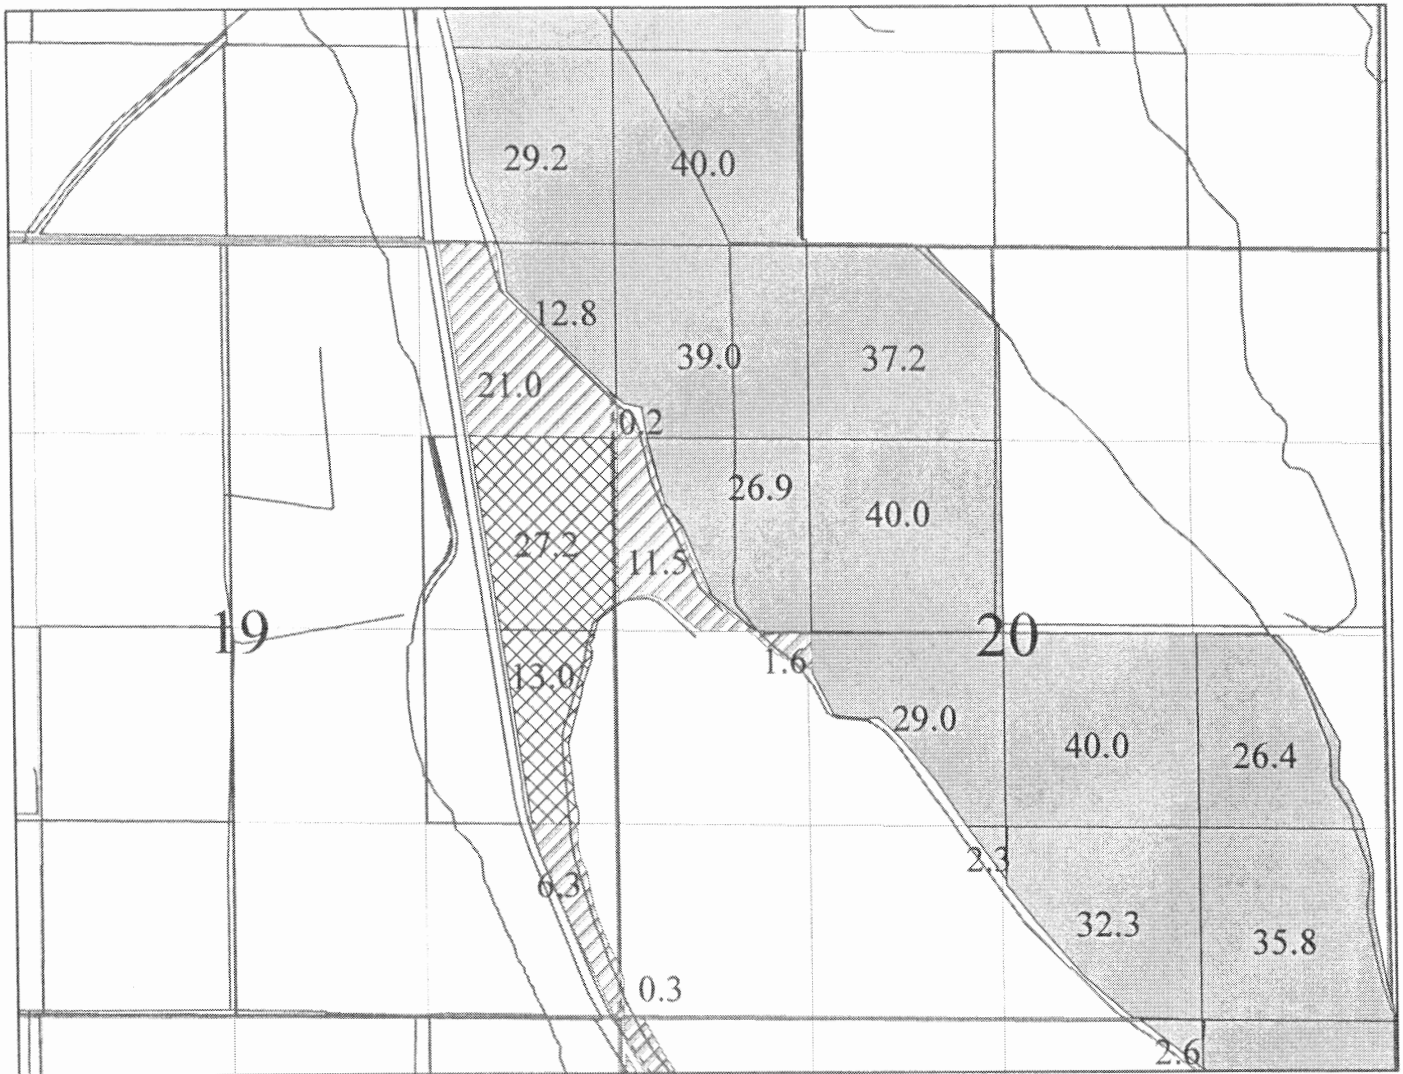

October 2015

Legend

Permit_S

- 9416; 18863; 25660
- 22962
- 51109