
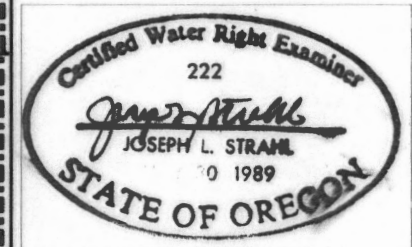


Claim of Beneficial Use Map

for

Application G-15878, Permit G-15478

T 40 S, R 19 E, Section 28, 29 & 32, W.M.

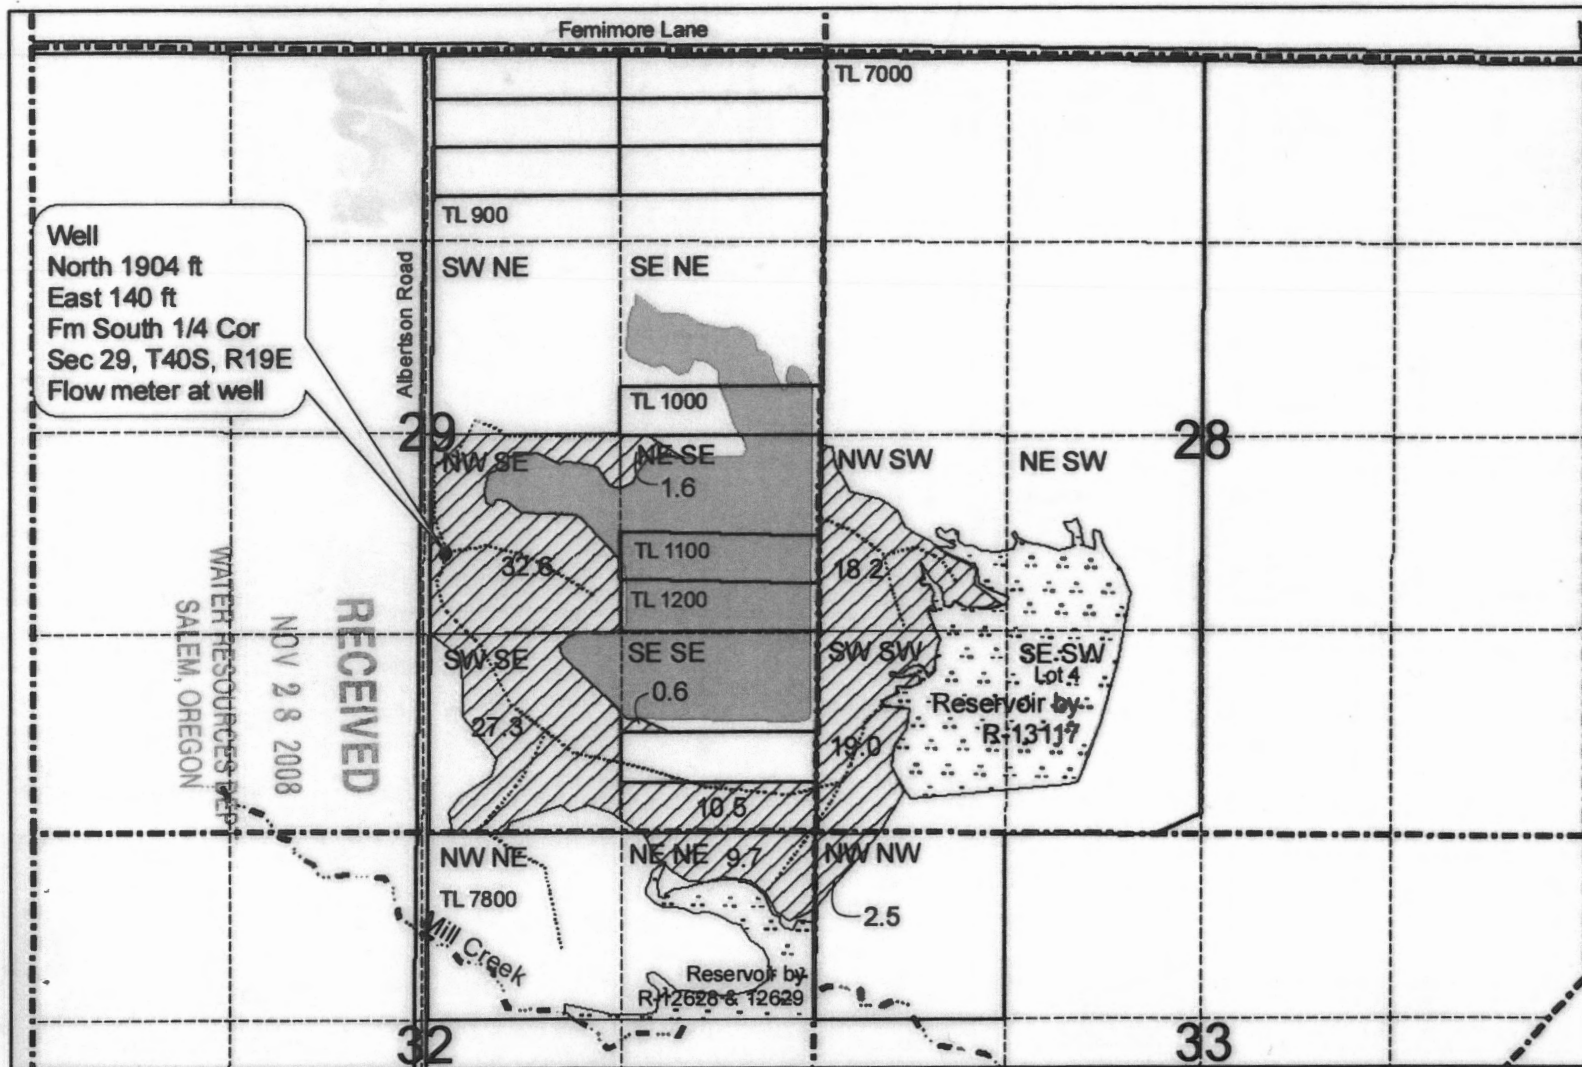

CWRE stamp

Note: This map is not to be used for property line location. It is to be used for water right purposes only.

Legend

-  Irrigated land
-  Res. by permit G15478
-  Supp. supply to res.
-  Ditch

N



Scale 1" = 1320'