

Claim of Beneficial Use Map for Metolius Meadows


APP G-6127 Per G-5218
PA T-9458

ESTES SURVEYS, LLC
 PO Box 47640 60382 Arnold Rd
 Salem, OR 97305-7640 Bend, OR 97702
 (503) 585-7593 (541) 382-7391

Permanent House X, RV use Y
 Section 16, T.13S., R. 9E., W.M.

This map is for the purpose of
 locating a water right only
 and has no intent to provide
 legal dimensions or the location
 of property lines.

Scale
 1" = 400'

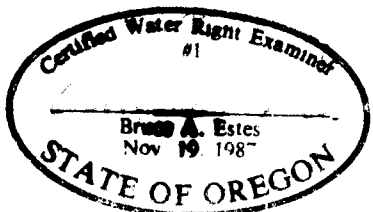

Surveyed Jan 8, 2007 21 22

